


T.12 S. R.2 E.W.M.

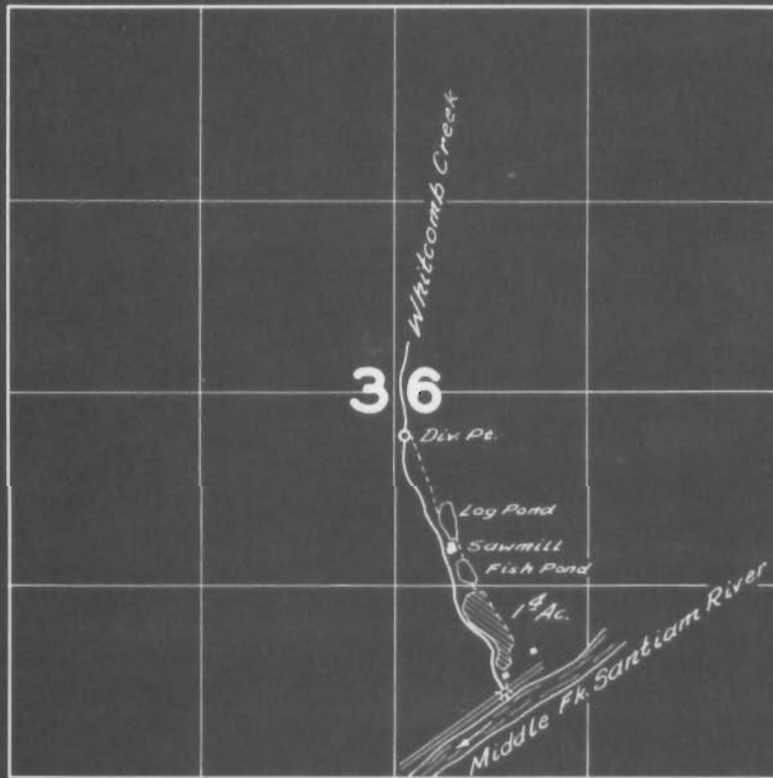

**FINAL PROOF SURVEY**  
UNDER

Application No. <sup>R-29373</sup> ~~29374~~ Permit No. <sup>R-1759</sup> ~~23670~~  
IN NAME OF

*Jack Farrell*

Surveyed *July 7, 1958*, by *C.D. Burtels*