


T.6S.R.1E.W.M.

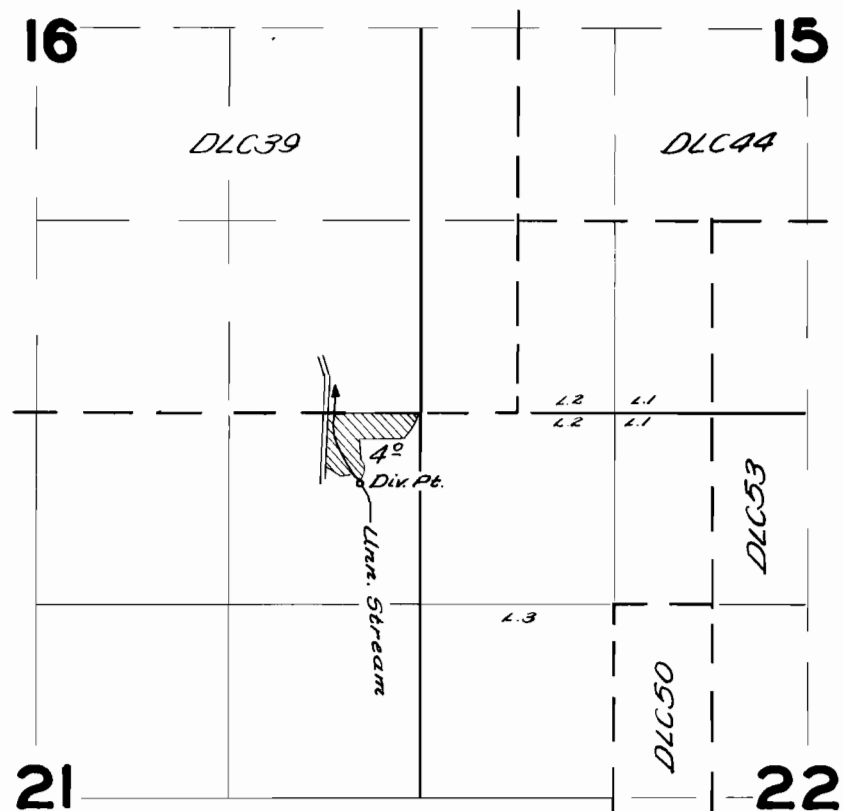

FINAL PROOF SURVEY UNDER

Application No. 30478 Permit No. 24005
IN NAME OF

Willis Nelson

Surveyed April 15 1958, by C.D. Barab