


T. 1N. R. 3W. W.M.

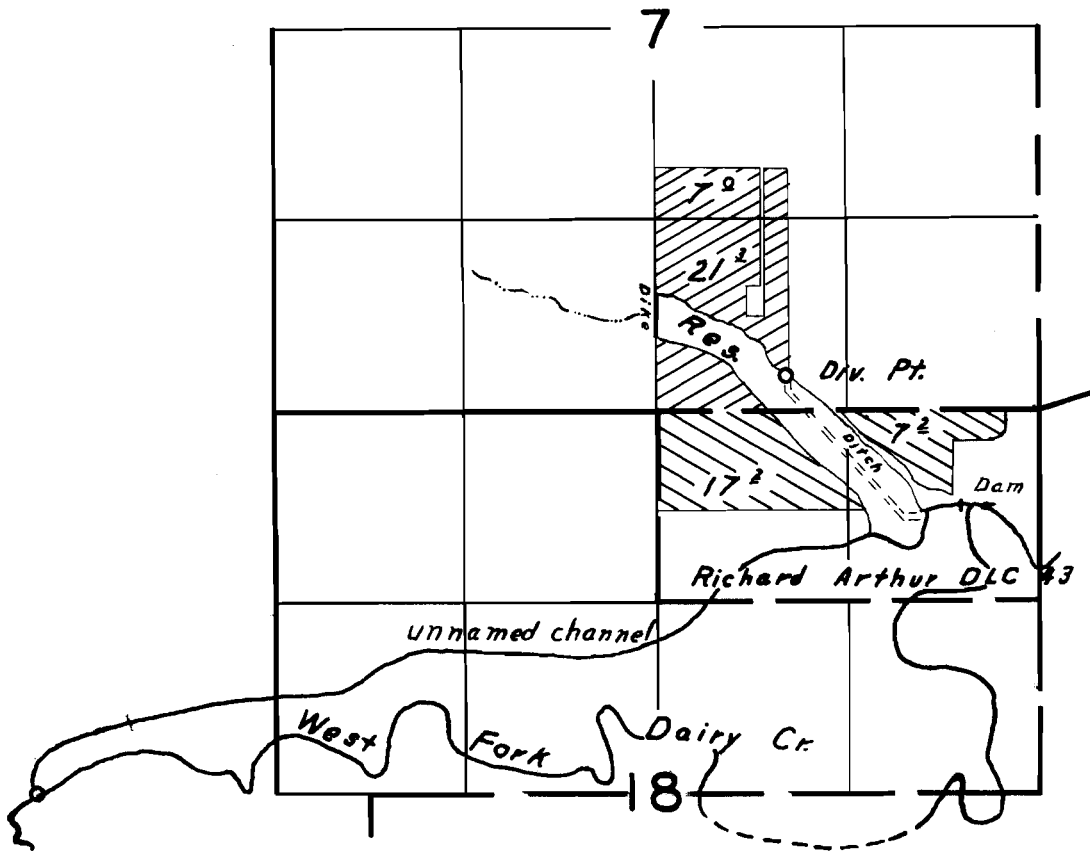

**FINAL PROOF SURVEY**

UNDER

Primary  Suppl. 

R-29603

R-1824

Application No. ~~29854~~ Permit No. 24066

IN NAME OF

*Adrian L. & Paulina E. Vandehy*

Surveyed *April 30 1958*, by *R. H. Whitby*