


T. 1N. R. 3W. W.M.

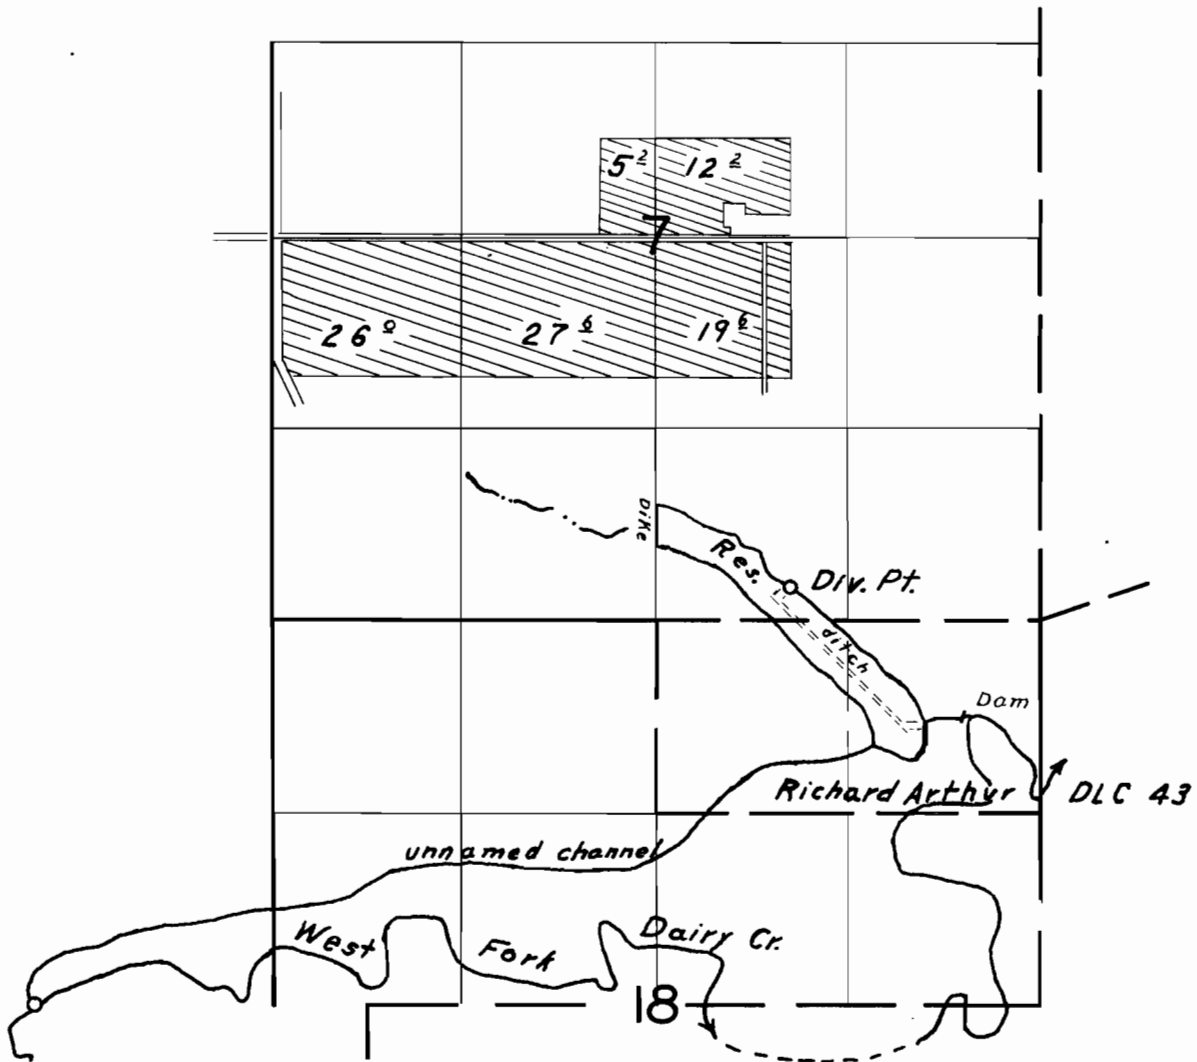

**FINAL PROOF SURVEY**  
UNDER

R-29603                      R-1834  
Application No. 29745 Permit No. 24064  
IN NAME OF

*Edward Vanderzanden*

Surveyed April 30 1958, by R.H. Whithy