


T. 1 N. R. 3 W. W.M.

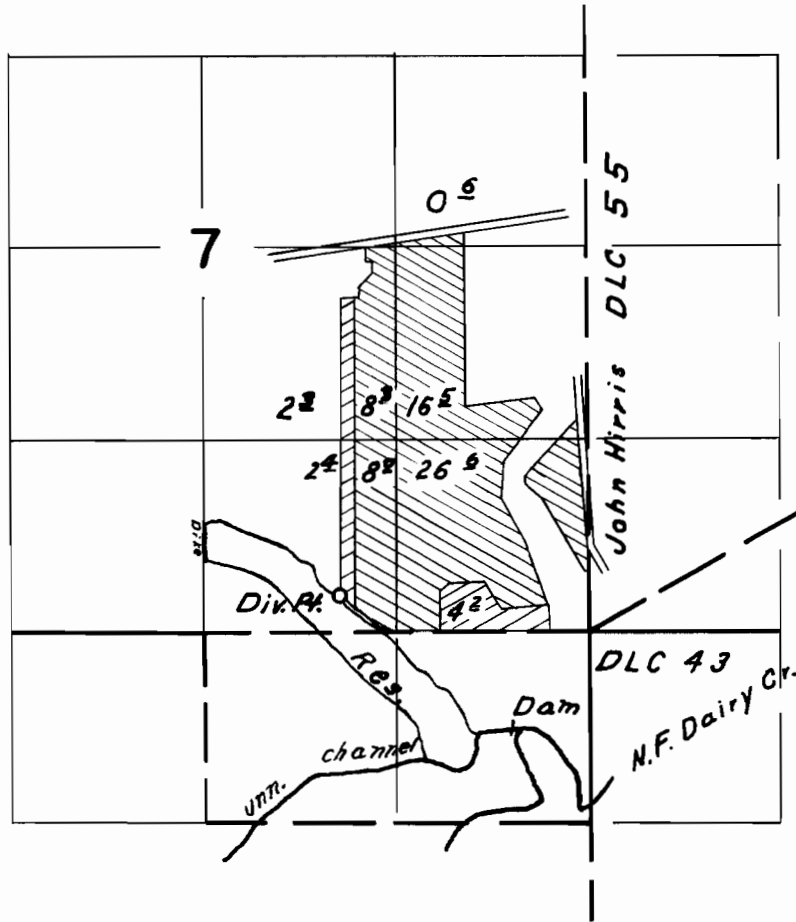

FINAL PROOF SURVEY
UNDER

Primary  Suppl. 

R-29603 R-1834
Application No. 29785 Permit No. 24065
IN NAME OF

Louis M. Spiering

Surveyed April 30 1958, by R.H. Whitby