


T. 1N. R. 3W. W.M.

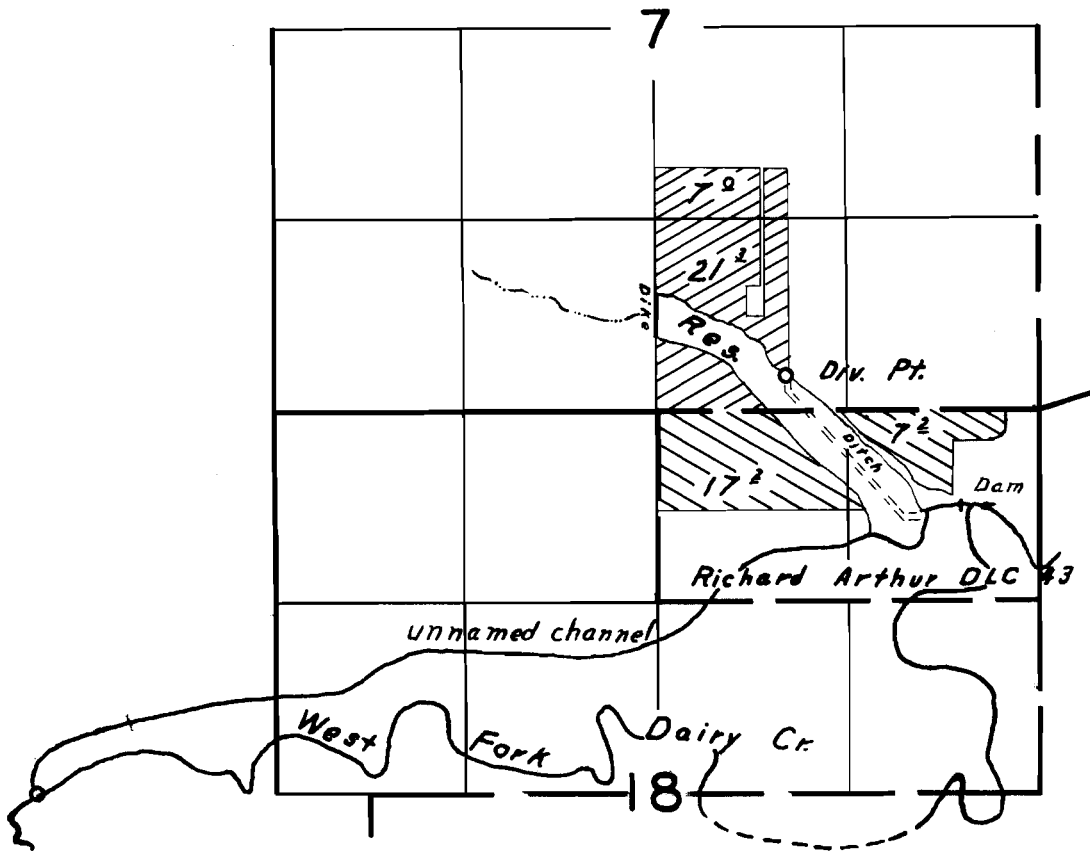

FINAL PROOF SURVEY

UNDER

Primary  Suppl. 

R-29603

R-1824

Application No. ~~29854~~ Permit No. 24066

IN NAME OF

Adrian L. & Paulina E. Vandehay

Surveyed *April 30 1958*, by *R. H. Whitby*