


T.9S. R.3W.W.M.

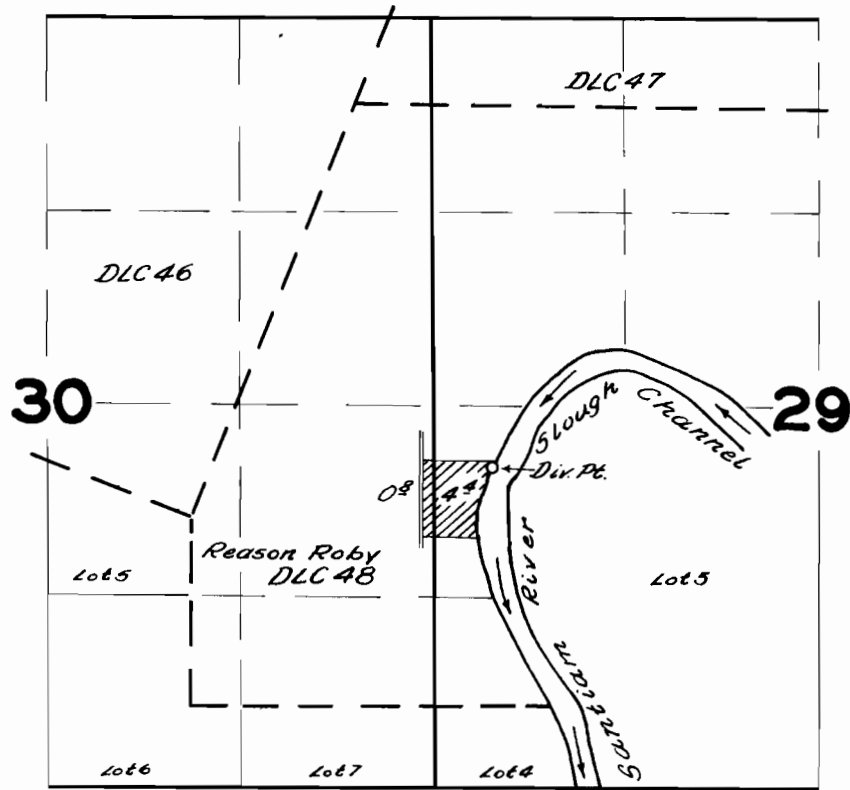

FINAL PROOF SURVEY UNDER

Application No. 30814 Permit No. 24257
IN NAME OF

Bertha F. Jorgenson

Surveyed *May 19* 1958, by *C.D. Bartab*