


T. 9 S. R. 40 E. W.M.

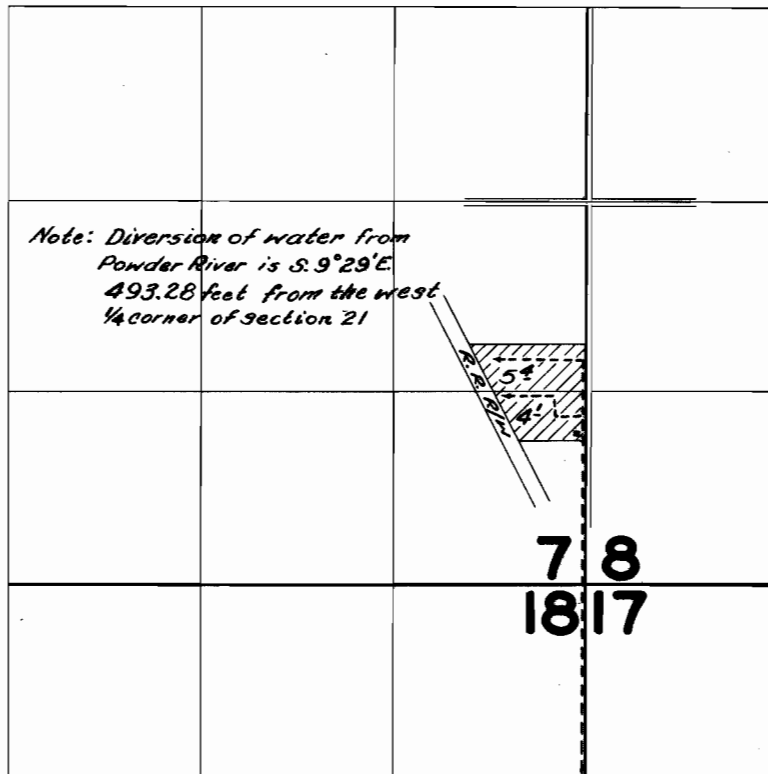

FINAL PROOF SURVEY UNDER

Application No. 30807 Permit No. 24315
IN NAME OF

Nels R. Pederson

Surveyed *Sept. 17* 1958, by *C.O. Bartlett*