


T.30 S.R.2 W.W.M.

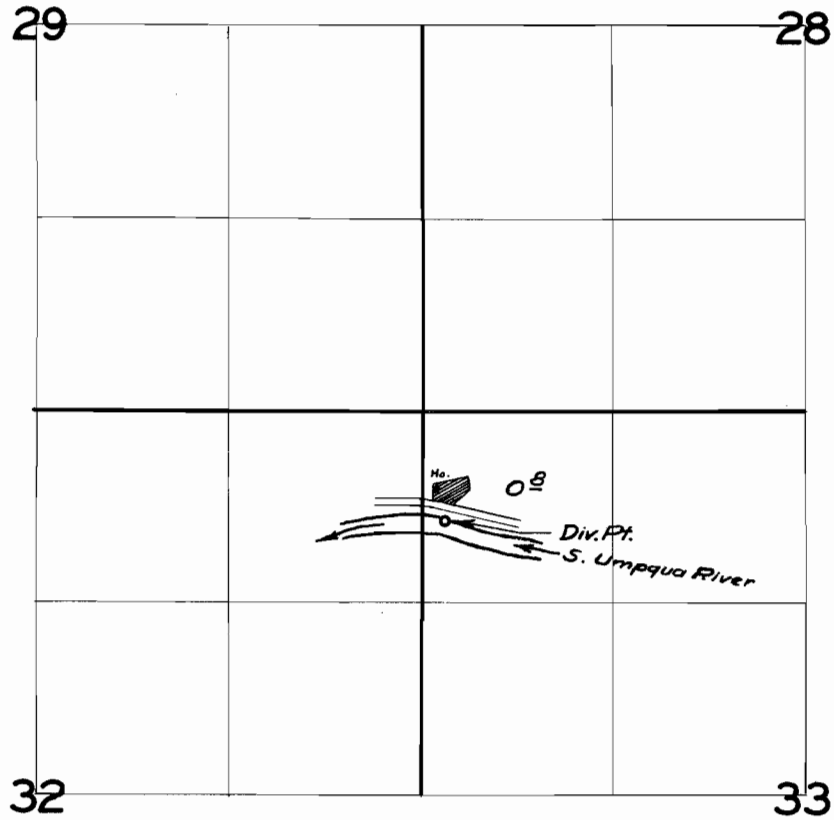

**FINAL PROOF SURVEY**  
UNDER

Application No. 30821 Permit No. 24317  
IN NAME OF

MARY & ANTON ERLEBACH

Surveyed 9 Sept. 1958, by M. Bish