


T. 8 S. R. 3 W. W. M.

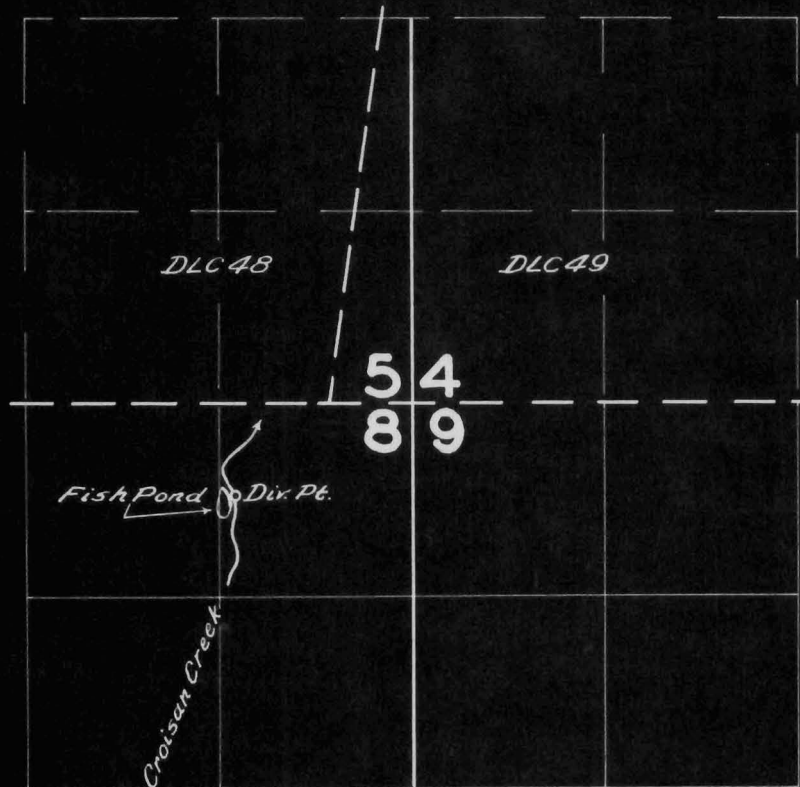

FINAL PROOF SURVEY
UNDER

Application No. ^{R-30870} 30871 Permit No. ^{R-1890} 24327
IN NAME OF

Chet I. & Dorothy S. Nelson

Surveyed *April 22 1958*, by *C.O. Burdick*