


T. 9S. R. 1E. W.M.

*Copy
from file
S-31080*

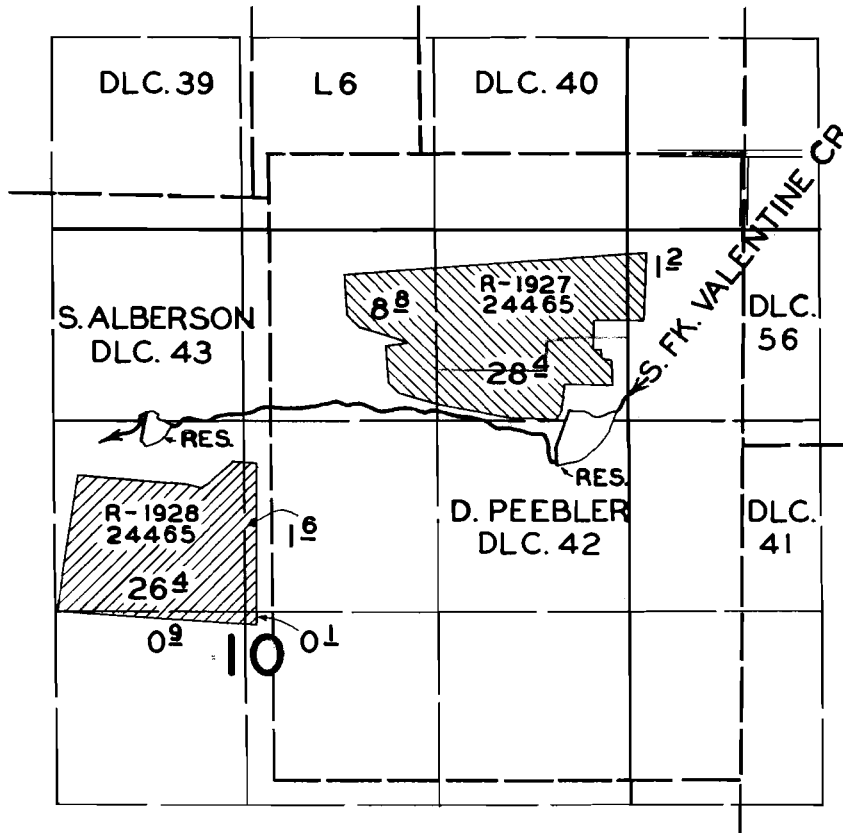

FINAL PROOF SURVEY

UNDER

R-31077

R-1927

31078

24464

R-31079

R-1928

Application No. 31080 . Permit No. 24465

IN NAME OF

DOUGLAS HEATER

Surveyed MAY 13, 1958, by *C.O. Bartel*