


T. 3S. R. 1E. W.M.

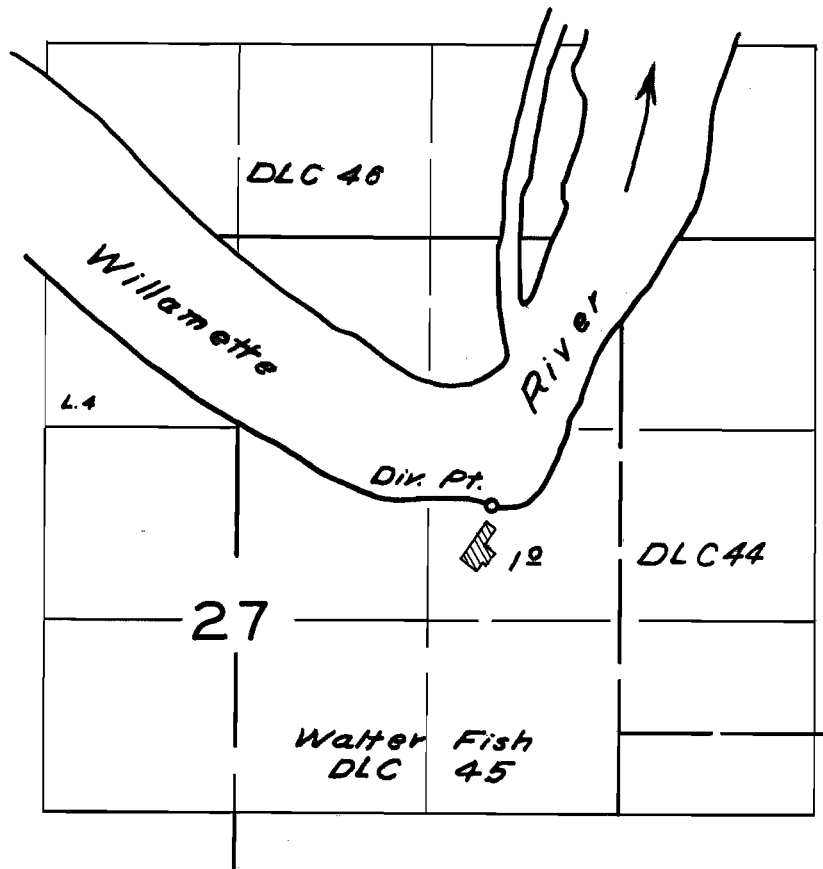

FINAL PROOF SURVEY
UNDER

Application No. 30961 Permit No. 24503
IN NAME OF

Blain H. & Huldah A. Watson

Surveyed Sept. 2 1958 by W. N. Perry

DFK-IP-117