


# T. 35S. R. 7E. W.M.

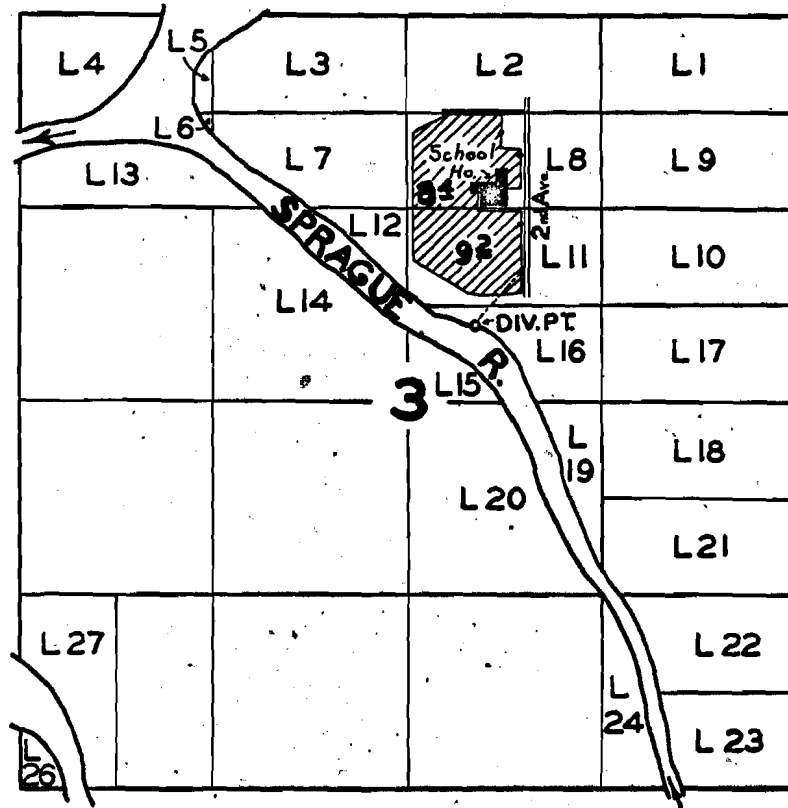

*Sprague River*

## FINAL PROOF SURVEY UNDER

Application No. 30923.. Permit No. 24537..  
IN NAME OF

**KLAMATH COUNTY SCHOOL DISTRICT**

Surveyed MAY 5... 1958., by *C.R. Burt*