


T.6S. R.3W.W.M.

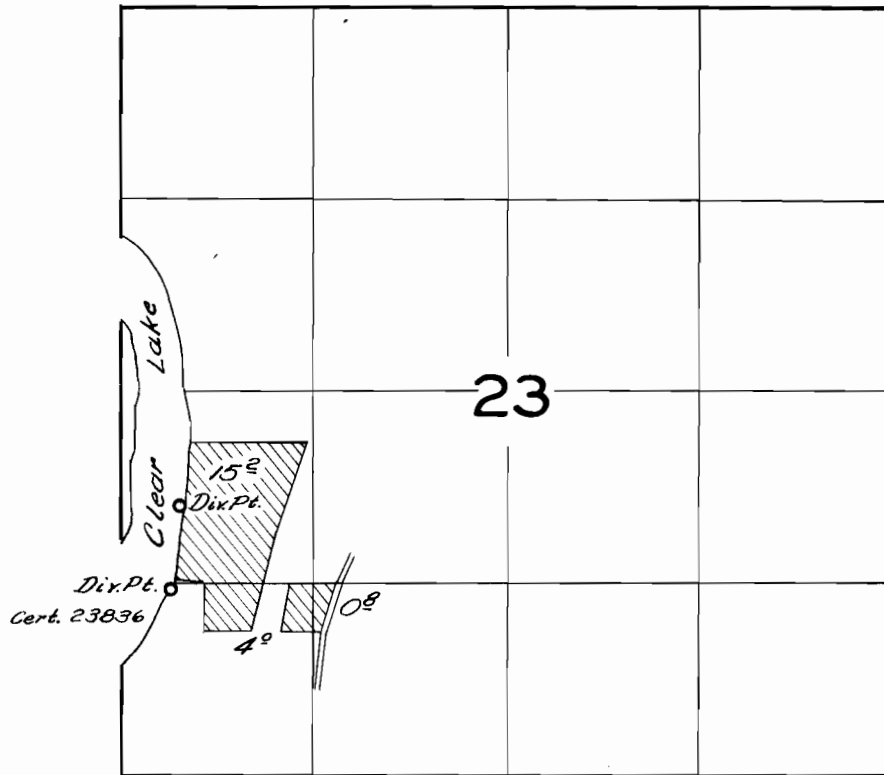

FINAL PROOF SURVEY
UNDER

Application No. 31379 Permit No. 24741
IN NAME OF

C. A. Bender, Jr.

Surveyed *June 12*, 1958, by *C. O. Bartels*