


T. 2S. R. 4E. W.M.

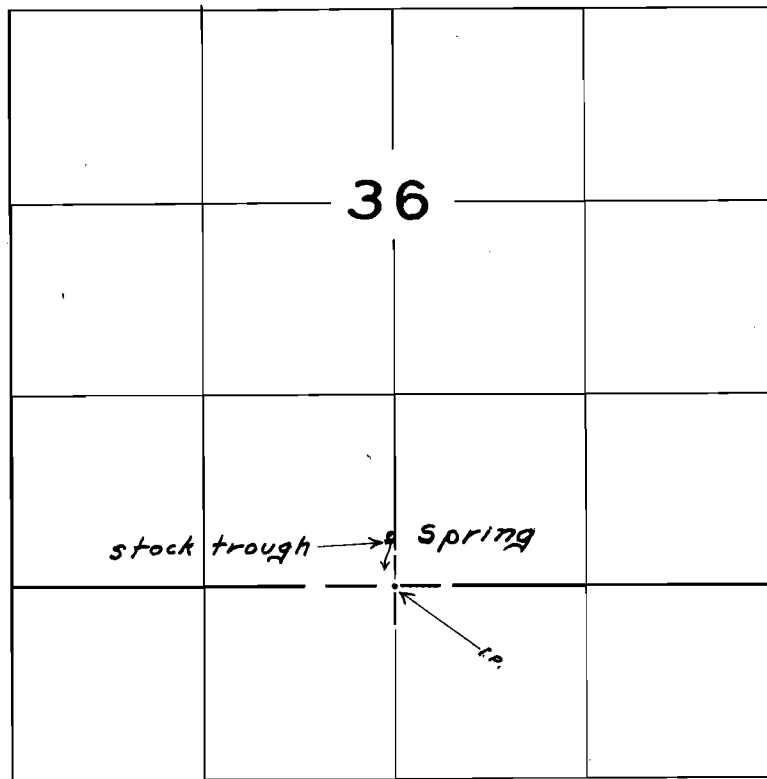

FINAL PROOF SURVEY
UNDER

Application No. 31474 Permit No. 24844
IN NAME OF

Emery M. Denbo

Surveyed Aug. 26 1958, by W. N. Perry