


T. 3S. R. 2E. W.M.

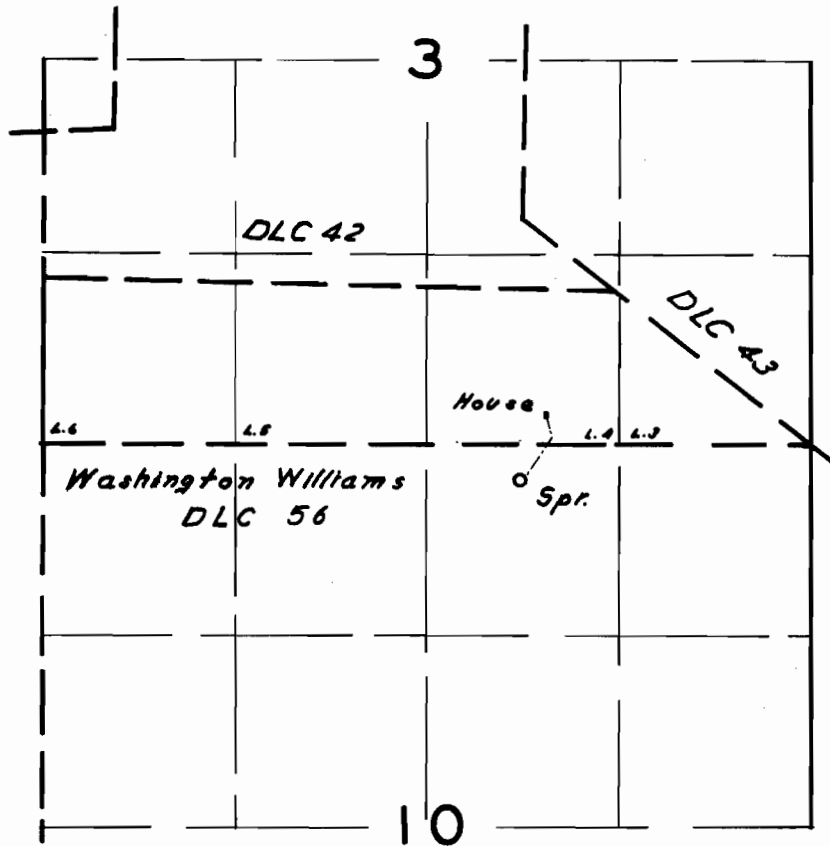

**FINAL PROOF SURVEY**  
UNDER

Application No. *31175* Permit No. *24952*  
IN NAME OF

*J. W. Watson*

Surveyed *July 7, 1958* by *W. N. Perry*