


T.I.S. R.I.E.W.M.

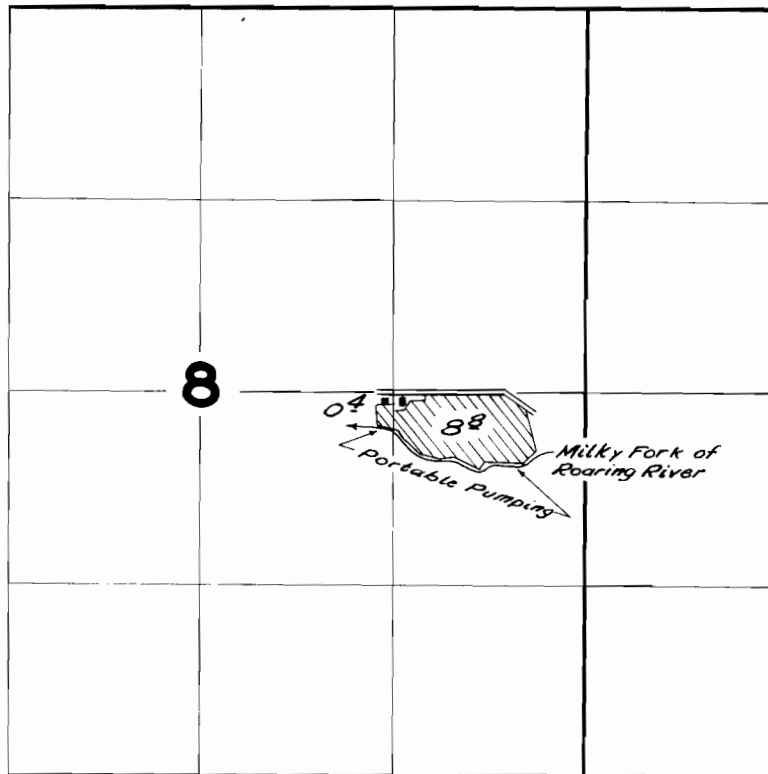

FINAL PROOF SURVEY
UNDER

Application No. 31695 Permit No. 24996
IN NAME OF

O. K. Howard

Surveyed July 10, 1958, by *C. D. Bartels*