


T. 18S. R. 46 & 47E. W.M.

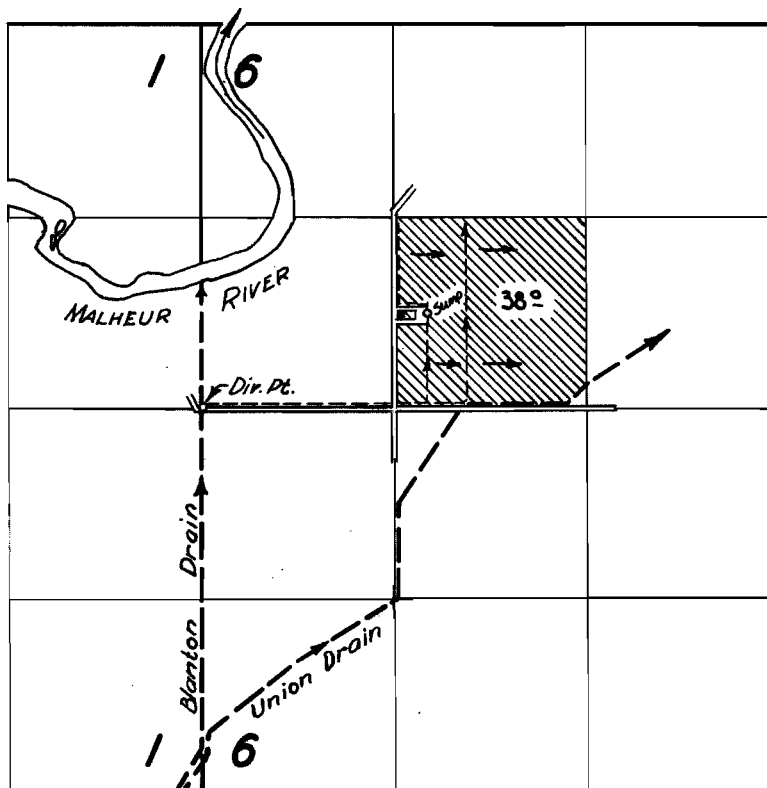

FINAL PROOF SURVEY
UNDER

Application No. 31718... Permit No. 25007...
IN NAME OF

CY WILLIAMS

Surveyed 28 Oct. 1958, by C.O. Bartels