


T.9S.R.3-4W.W.M.

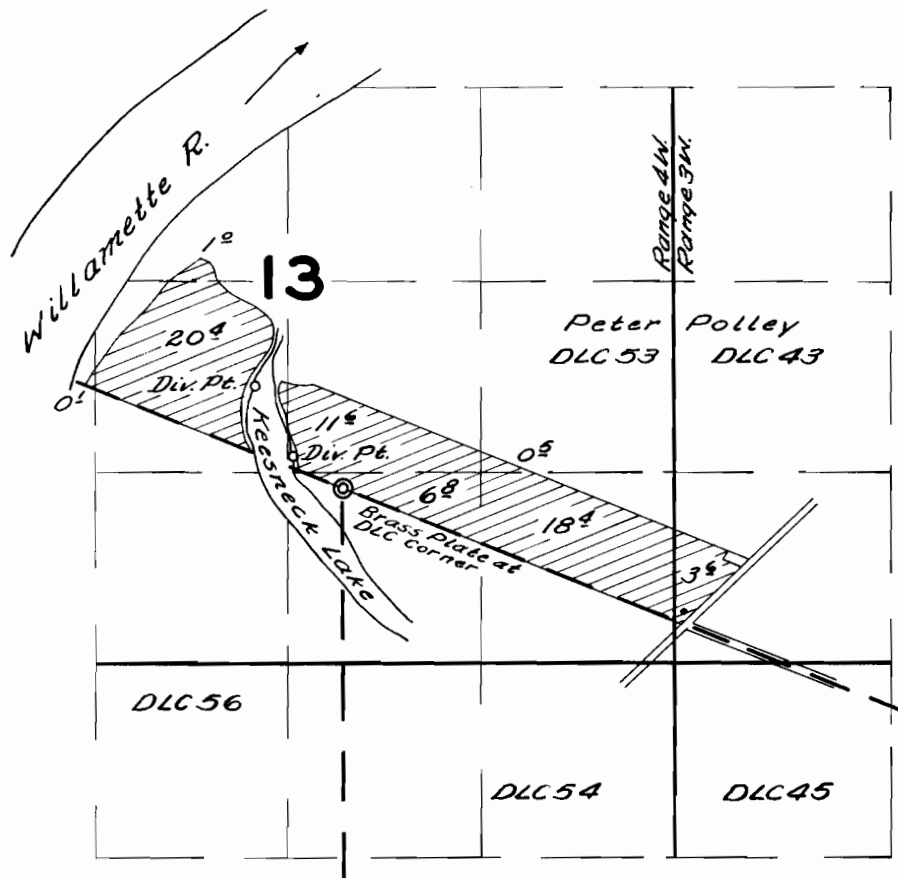

FINAL PROOF SURVEY UNDER

Application No. 31417 Permit No. 25019
IN NAME OF

Claude Pilcher

Surveyed *May 19 1958*, by *C.D. Bartels*