


T.9S. R. 3W.W.M.

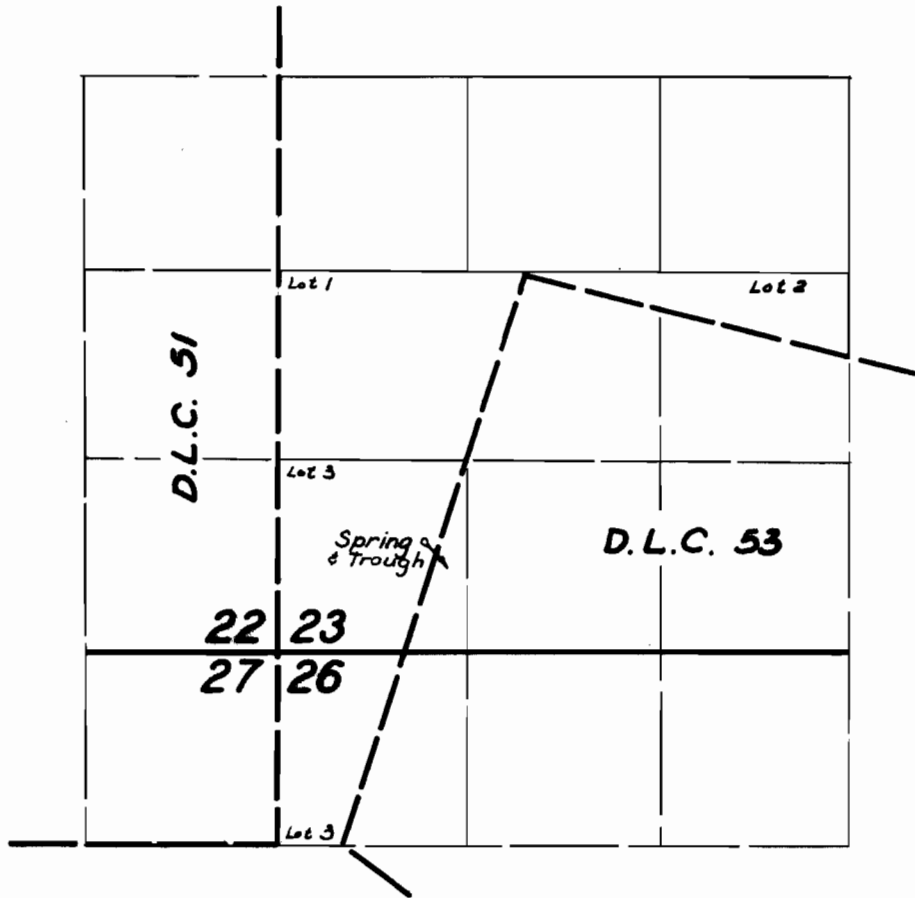

FINAL PROOF SURVEY
UNDER

Application No. 32021... Permit No. 25260
IN NAME OF

MERLE F. & BERTHA M. HOLMAN

Surveyed 30 Sept. 1958, by C.O. Bartels.