


T. 3N. R. 4W. W.M.

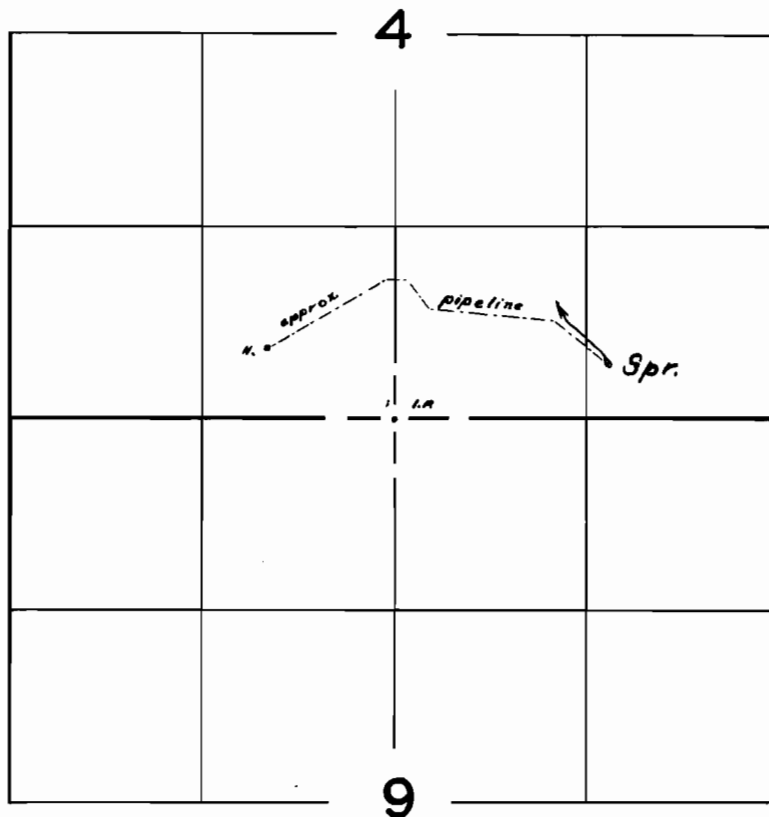

FINAL PROOF SURVEY
UNDER

Application No. 32023 Permit No. 25262
IN NAME OF

Charles W. & Erna J. Yost

Surveyed May 8 1958, by R.H. Whitby