


T.38S. R.11½E.W.M.


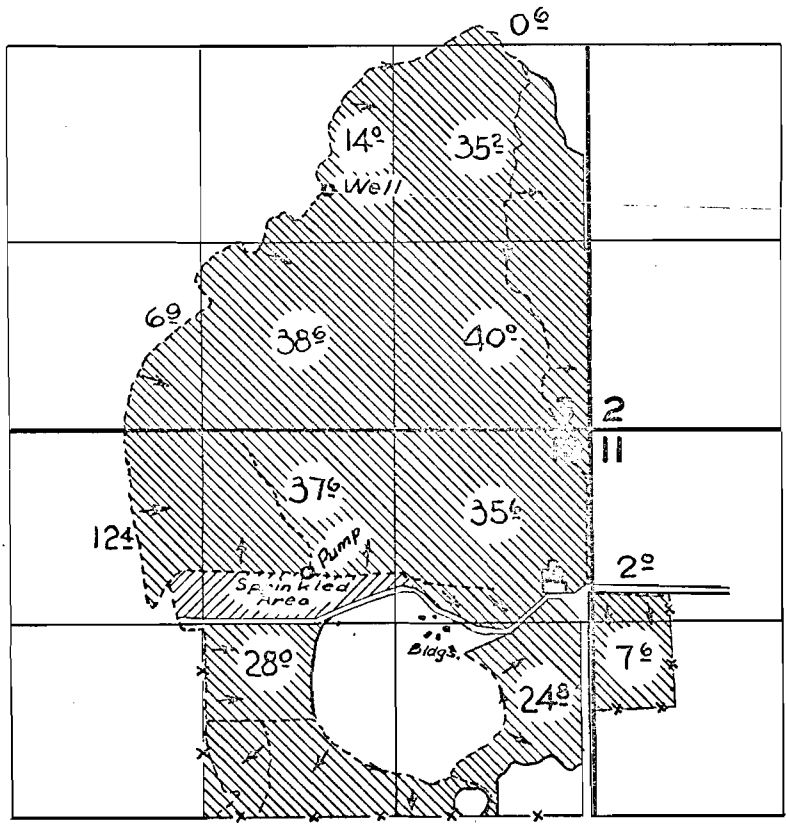

FINAL PROOF SURVEY
UNDER

Application No. U-306 Permit No. U-279
IN NAME OF

JESSE N. DREW

Surveyed 29 April 1958, by C.O. Bartels.