


T.38S. R.10E.W.M.

Swan Lake Wells

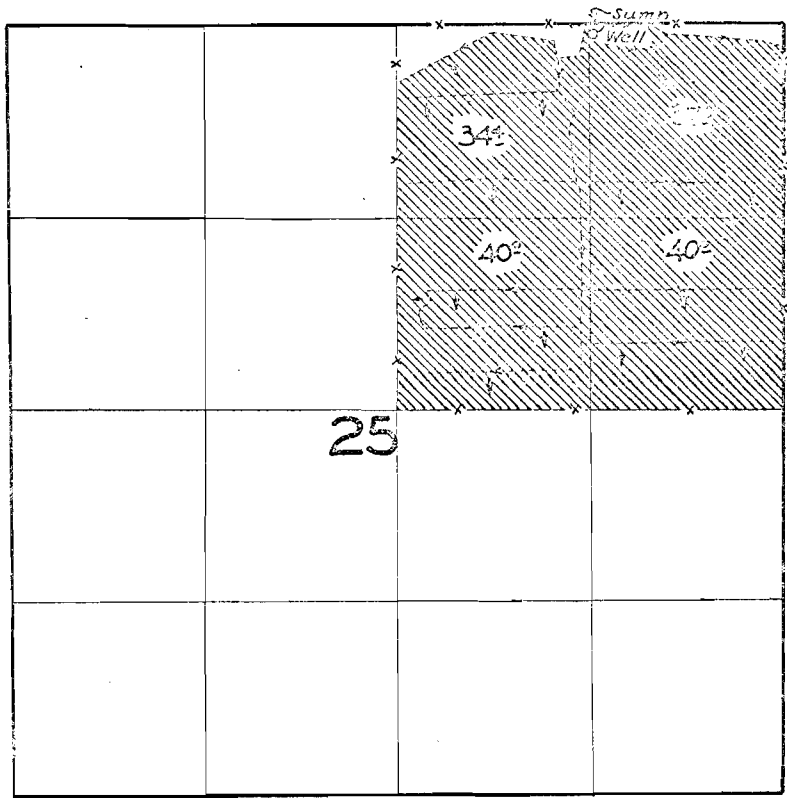

FINAL PROOF SURVEY  
UNDER

Application No. U-333. Permit No. U-307.  
IN NAME OF

GARRISON C. & EMMA M. MITCHELL

Surveyed 1 May 1958, by C.O. Bartels