


T. 39S. R. 20E.W.M.

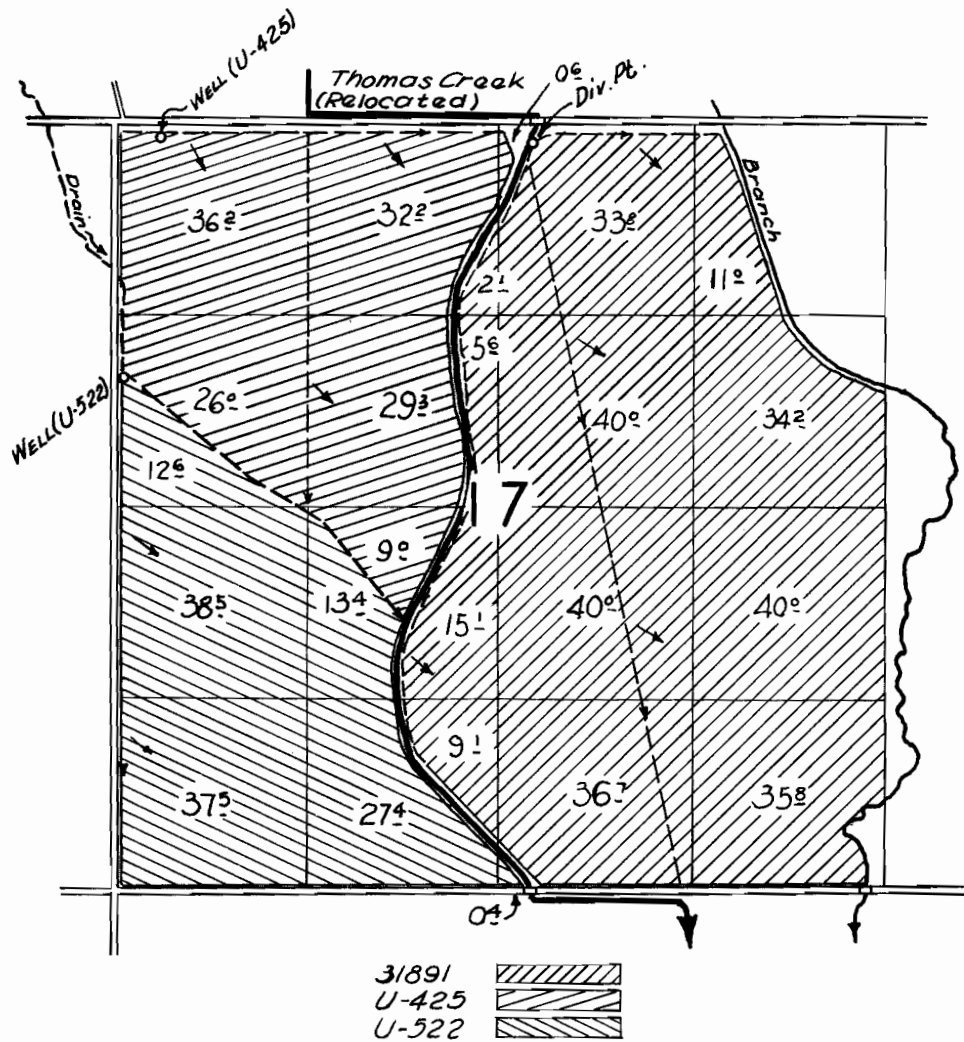

FINAL PROOF SURVEY
UNDER

31891 25614
 U-425 U-393
 Application No. U-522 Permit No. U-474
 IN NAME OF
 HARRY HUNTER ESTATE, INC. &
 FAYELL-UTLEY REALTY CO.

Surveyed 13 May 1959, by *L. Jackson*