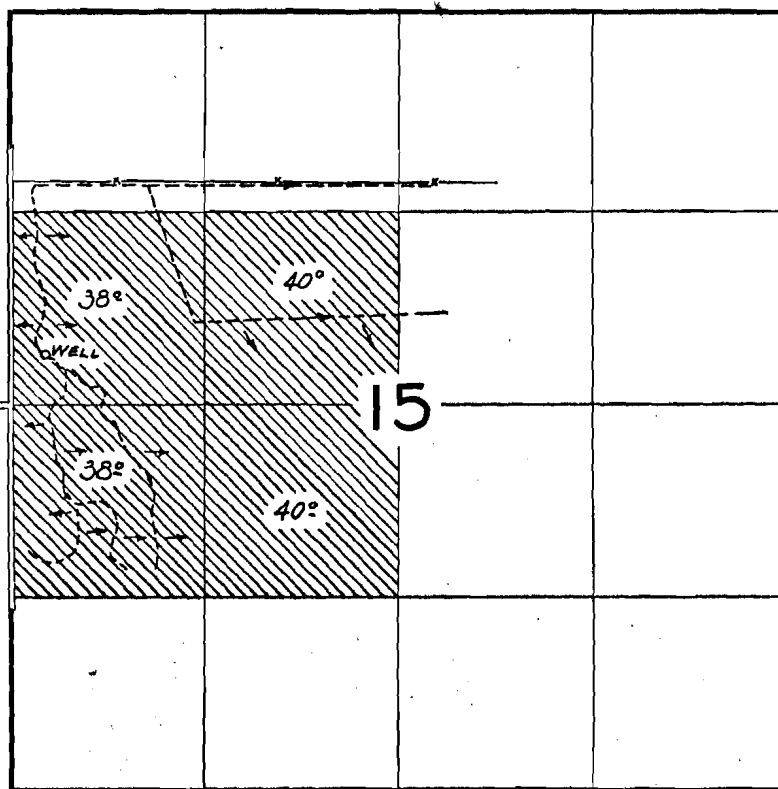


T.40S. R.19E.W.M.

**FINAL PROOF SURVEY**
UNDERApplication No. G-147 Permit No. G-43
IN NAME OFSOUTHERN OREGON RANCHES, INC.Surveyed @ May 1959, by R. Jackson