


U-397

C-26516

T.6N. R.35&36E.W.M.

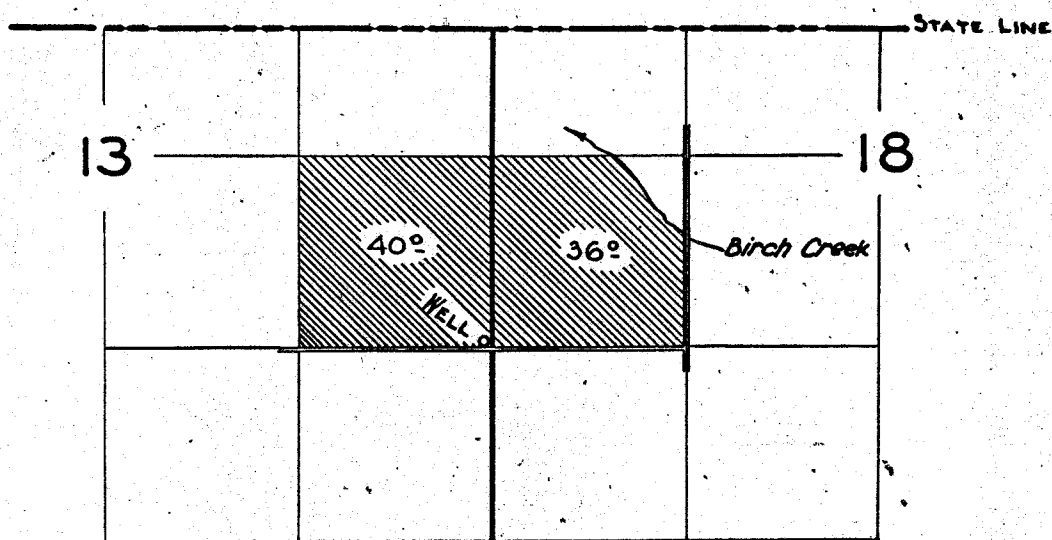

FINAL PROOF SURVEY
UNDER

Application No. U-432.. Permit No. U-397..
IN NAME OF

CARL A. ANDERSON

Surveyed 14 Nov. 1958, by C.O. Bartels.

NZ-SF-102