


T.16S. R.43E.W.M.

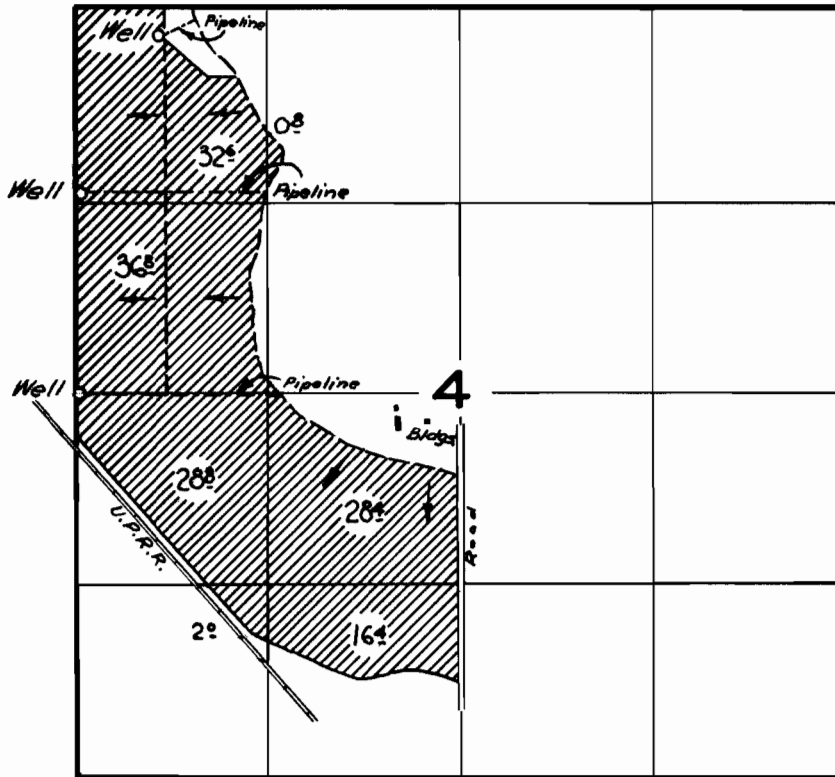

FINAL PROOF SURVEY
UNDER

Application No. U-362.. Permit No. U-446..
IN NAME OF

NORTH JAMIESON FARMS, INC.

Surveyed 14 Oct. 1958, by C.O. Bartels.