


U-951  
C-26519

T.6N. R.35 E.W.M.

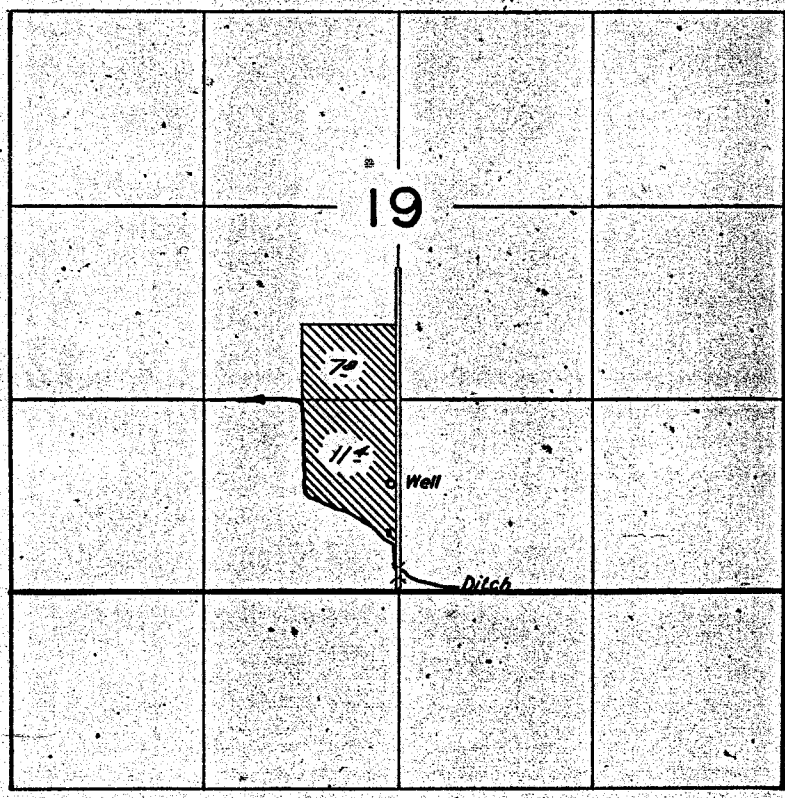

**FINAL PROOF SURVEY**  
UNDER

Application No. U-497. Permit No. U-451.  
IN NAME OF

**C. F. HENRICHS**

Surveyed 13 Nov. 1958., by C.O. Bartels.