


U-611
C-26521

T.6N. R.35 E.W.M.

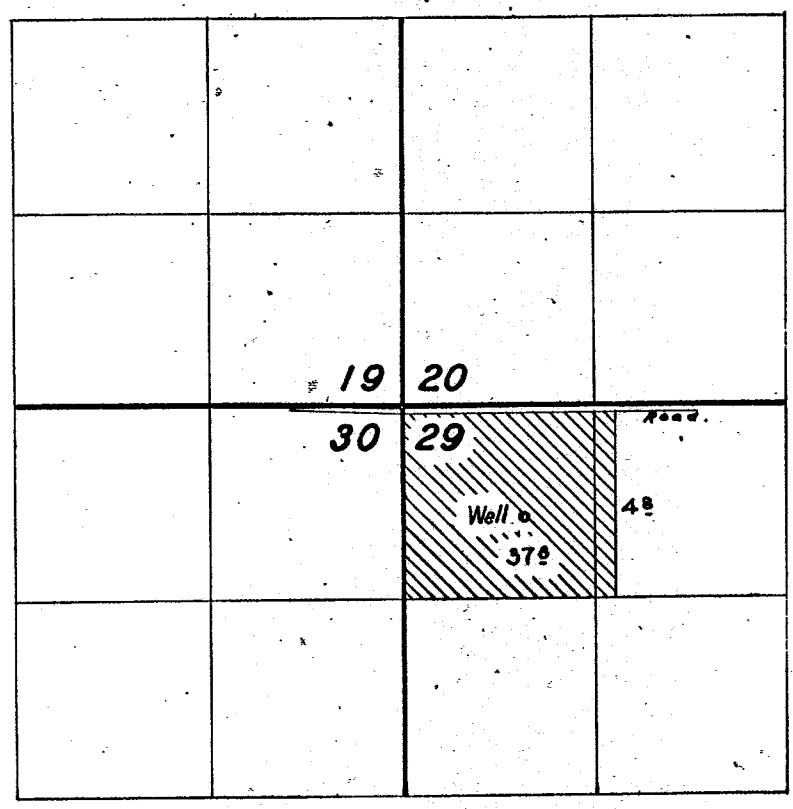

FINAL PROOF SURVEY UNDER

Application No. U-678... Permit No. U-611...
IN NAME OF

EDWIN L. McEWEN

Surveyed 14 Nov. 1958, by C.O. Bartels.