


T. 15S. R. 40 E. W.M.

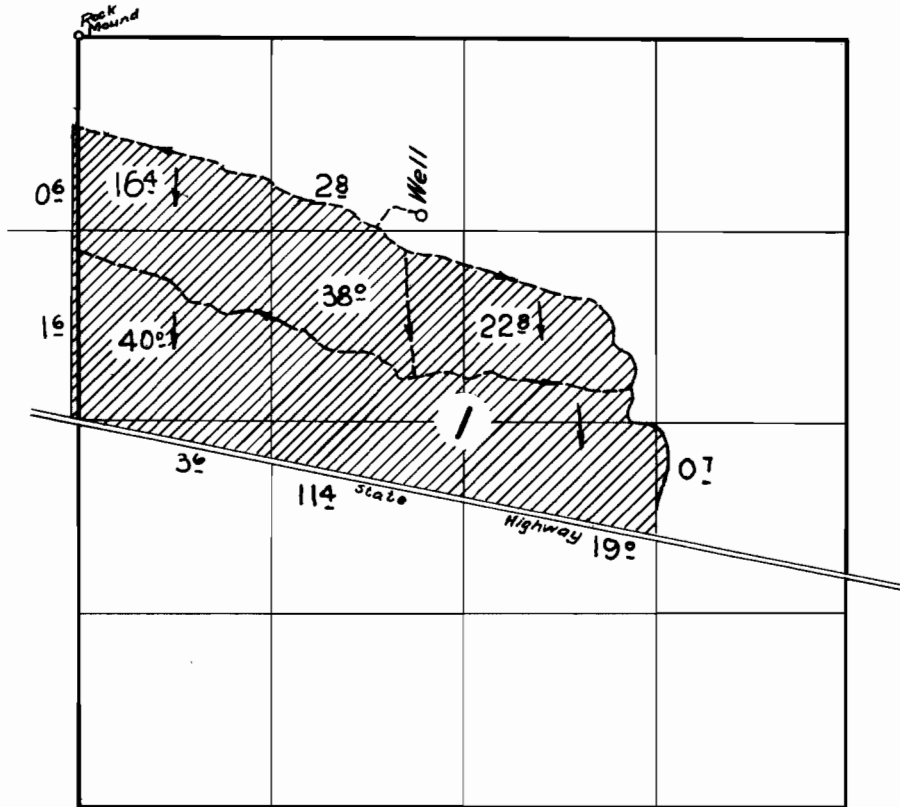

FINAL PROOF SURVEY
UNDER

Application No. U-686 Permit No. U-629
IN NAME OF

ALTHA ANDERSON

Surveyed 15 Oct. 1958, by C. O. Bartels.