


T.41S.R.35E.W.M.

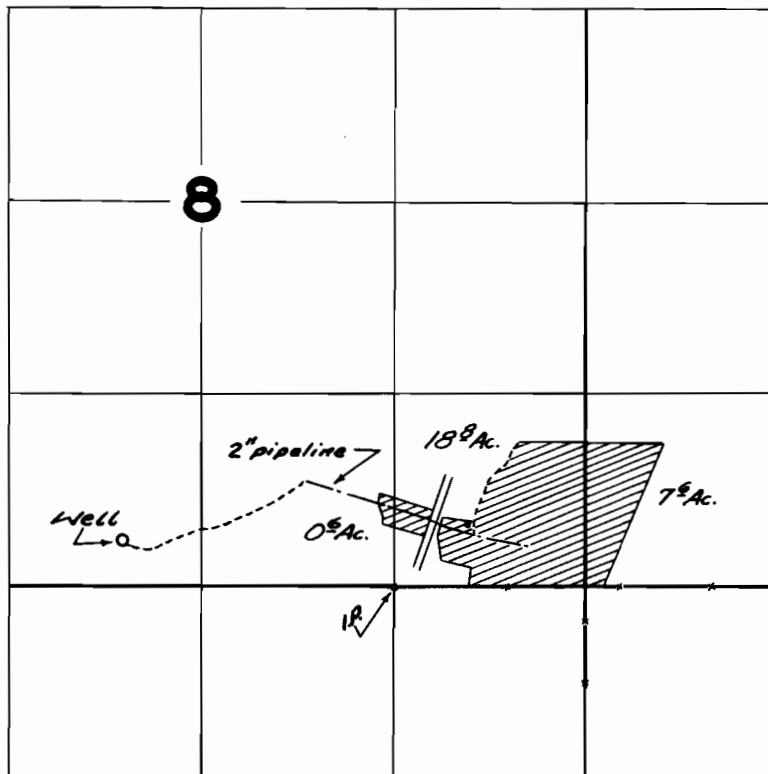

FINAL PROOF SURVEY UNDER

Application No. *U-799* Permit No. *U-703*
IN NAME OF

Irwin E. Smith

Surveyed *July 22, 1958*, by *C. O. Bartels*