


T. 8S. R. 3W. W.M.

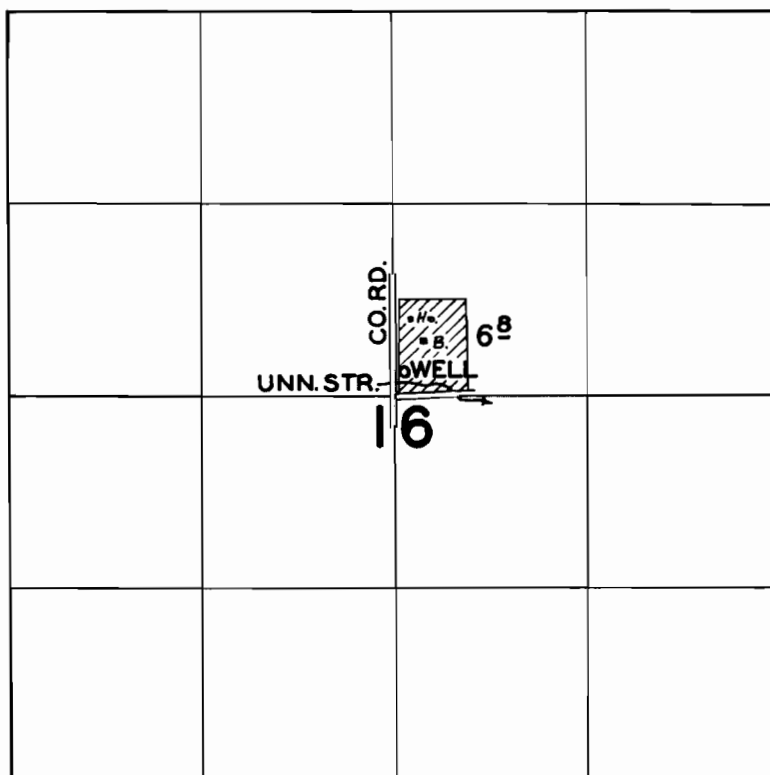

FINAL PROOF SURVEY
UNDER

Application No. G-187 Permit No. G-61
IN NAME OF

E. L. GREENLEAF

Surveyed MAY 23 1958, by C.O. BARTELS