


T.17S. R. 47 E. W.M.

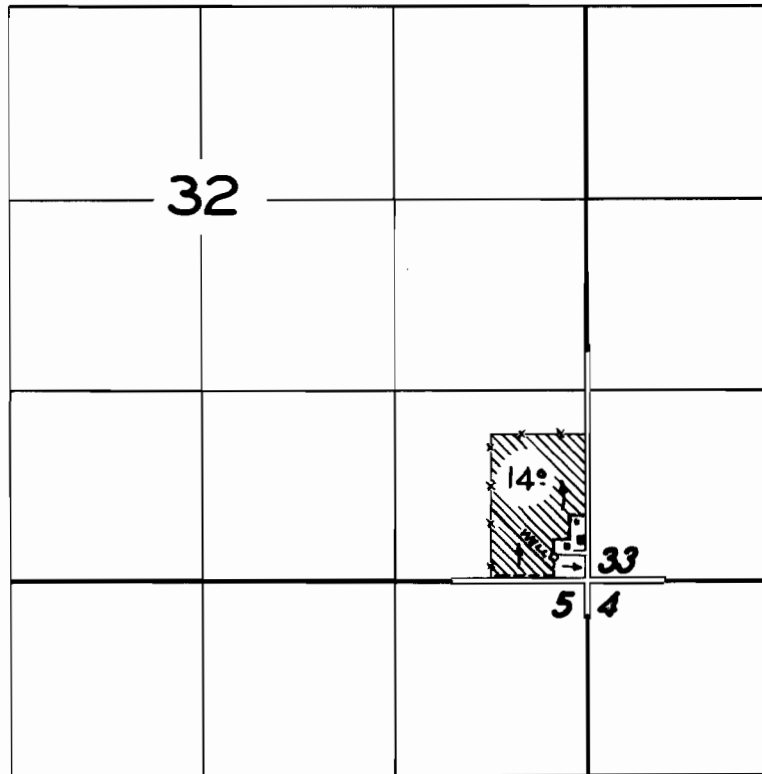

FINAL PROOF SURVEY
UNDER

Application No. G-195 Permit No. G-123
IN NAME OF

JACK J. KOCH

Surveyed 29 Oct. 1958, by C.O. Bartels