


T.6N. R.35E.W.M.

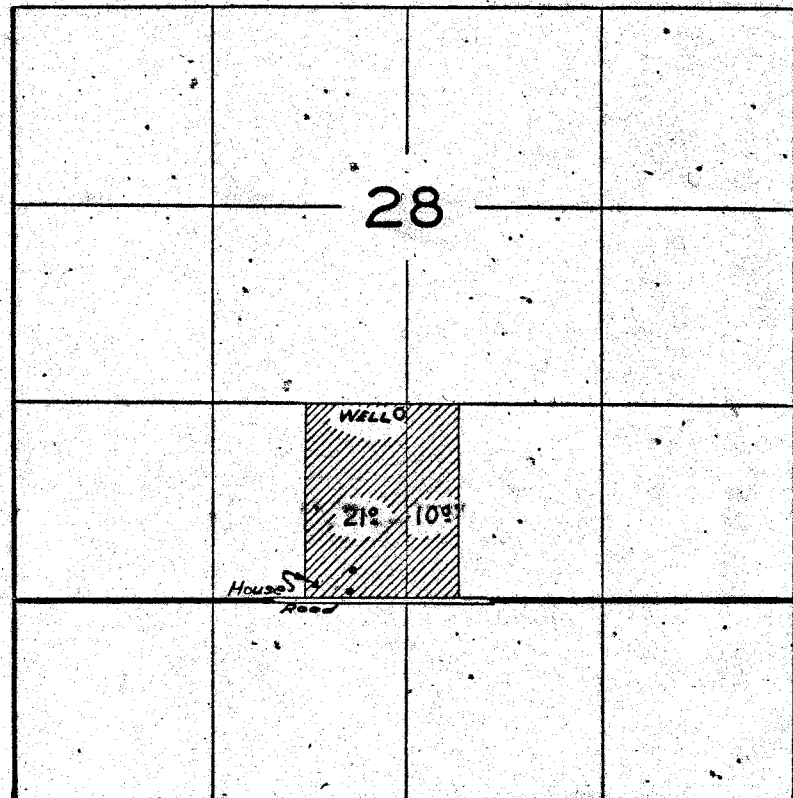

FINAL PROOF SURVEY UNDER

Application No. G-212 Permit No. G-131
IN NAME OF

MURREL OLIVER

Surveyed 14 Nov. 1958. by C.O. Bartels.