


# T5SR3WWM

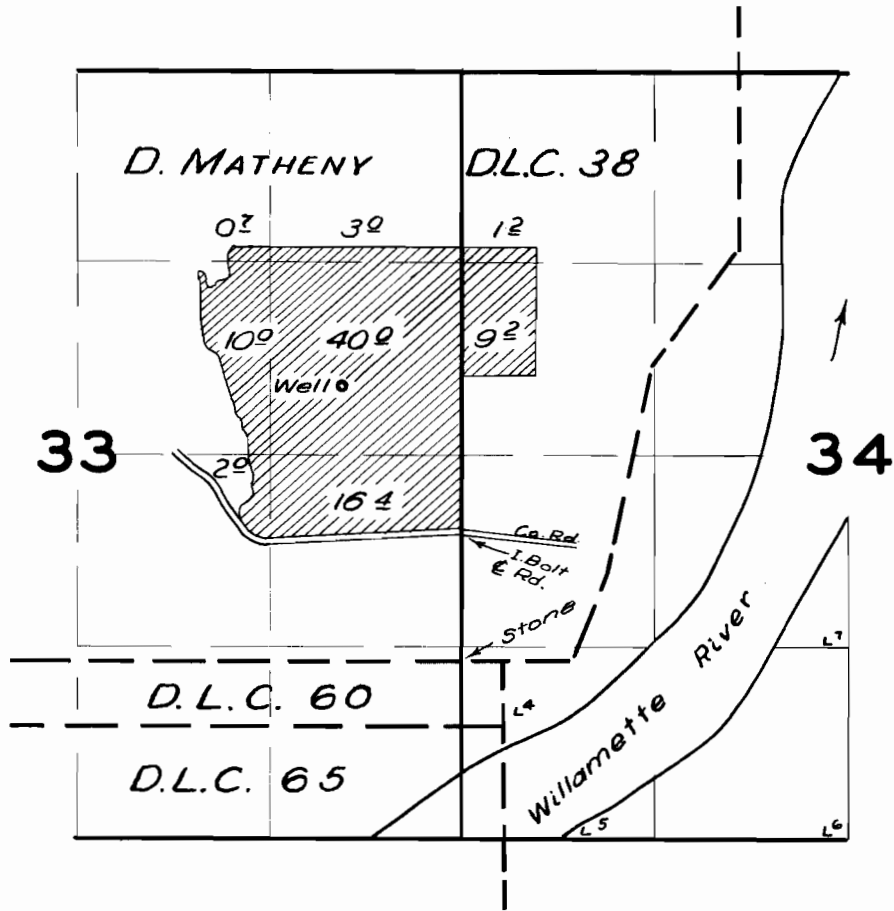

## FINAL PROOF SURVEY UNDER

Application No. G-256. Permit No. G-201  
IN NAME OF  
UNITED STATES NATIONAL BANK OF PORTLAND  
TRUSTEE FOR CORA LEONARD

Surveyed 3 April 1958, by *M. G. Bish*