


T. 4S. R. 1 E. W. M.

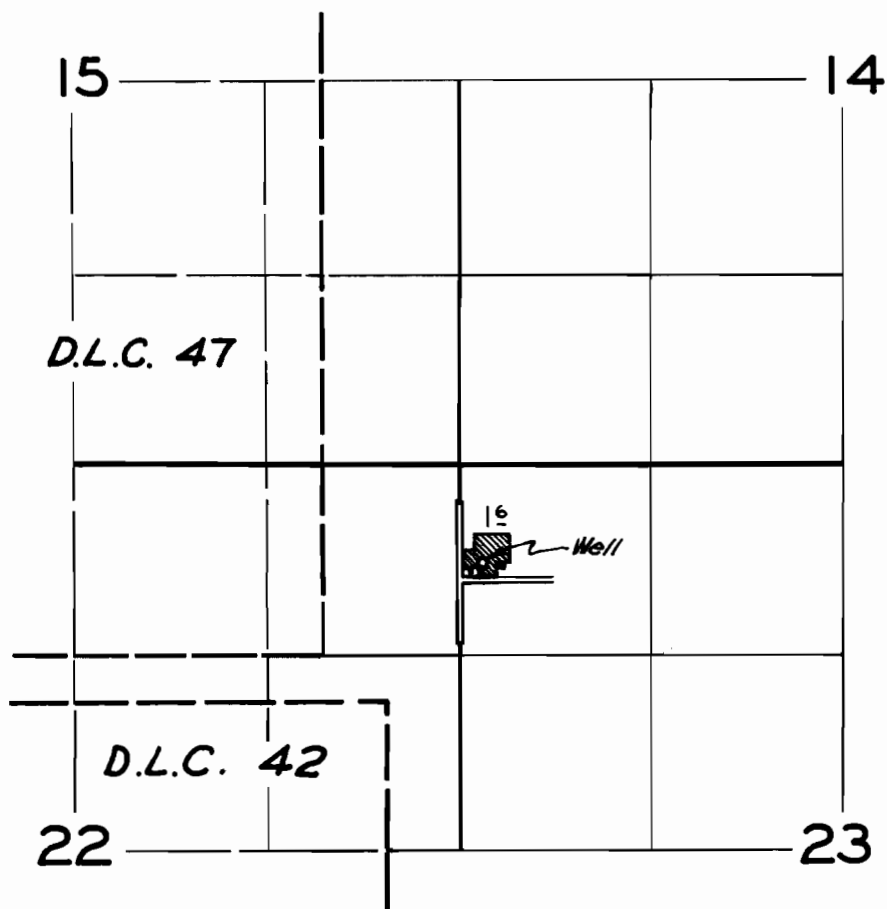

FINAL PROOF SURVEY
UNDER

Application No. G-376 Permit No. G-252
IN NAME OF

HAROLD A. JENSEN

Surveyed 13 August 1958, by C.O. Bartels