


T.8S. R.4 W.W.M.

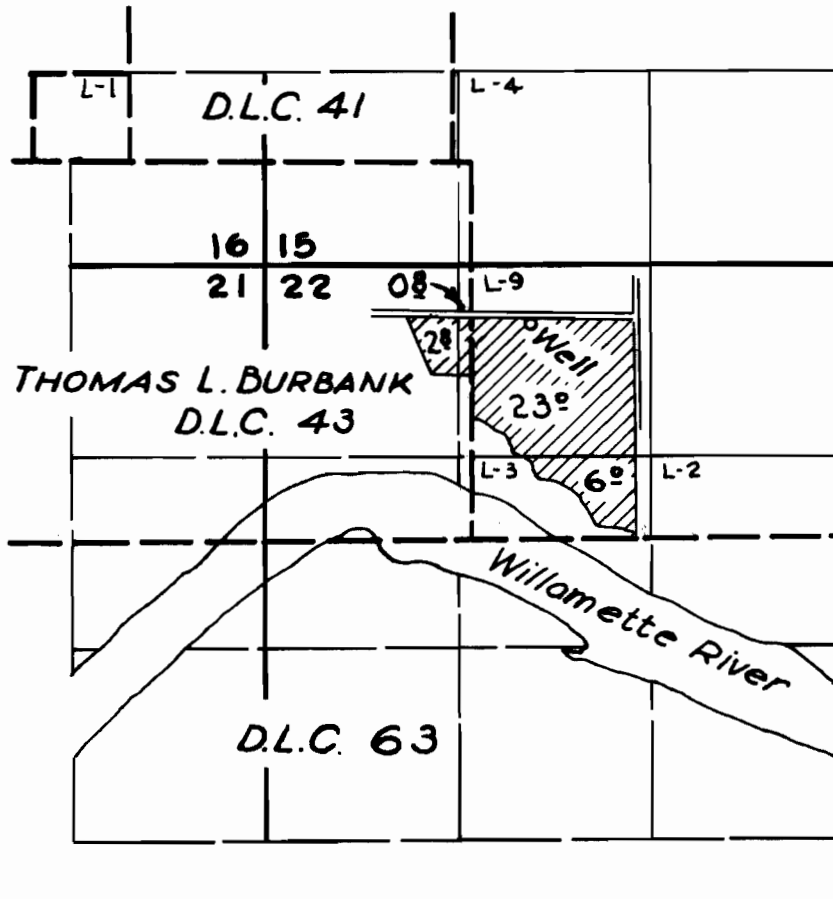

FINAL PROOF SURVEY
UNDER

Application No. G-490 Permit No. G-377
IN NAME OF

DEAN WALKER FARMS

Surveyed April 22 1958, by R.H. Whitby