


T. 10 S. R. 3 W. W.M.

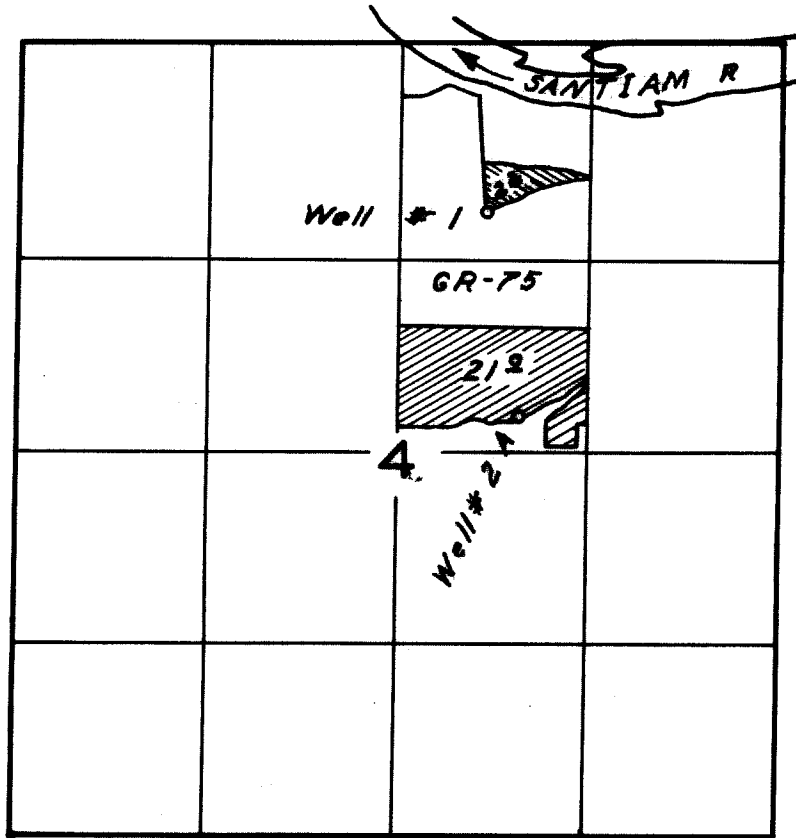

FINAL PROOF SURVEY
UNDER

primary  suppl. 
Application No. G-525 Permit No. G-407
IN NAME OF

Carl Tanack

Surveyed *Sept. 3, 1958*, by *W. N. Perry*.