


G-483
26533

T.6N. R.35E.W.M.

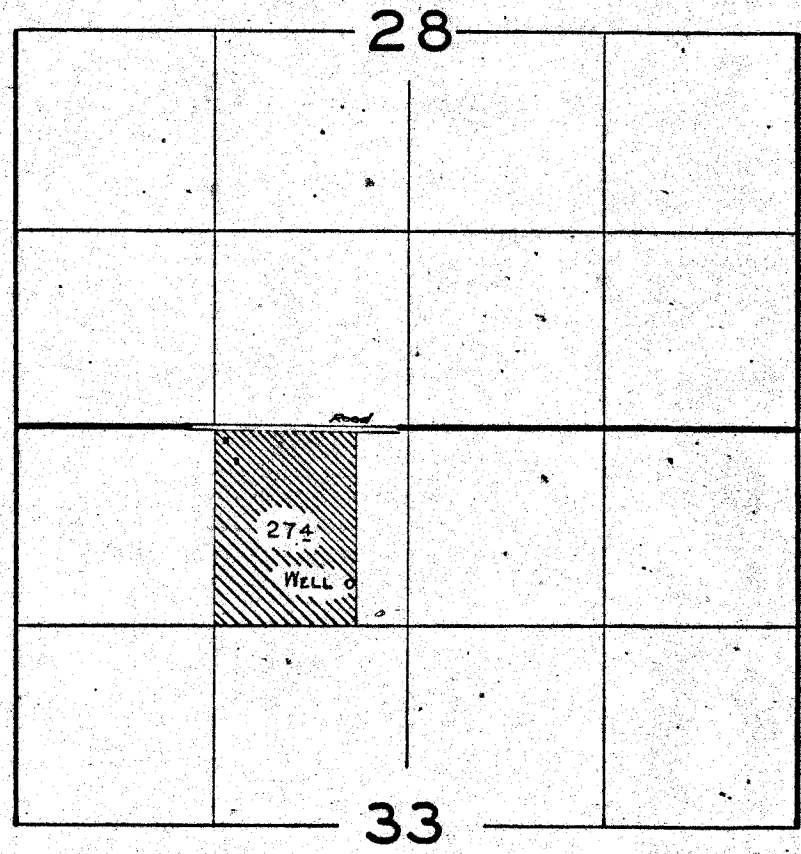

FINAL PROOF SURVEY
UNDER

Application No. G-10 Permit No. G-483
IN NAME OF

RICHARD KNOFF

Surveyed 14 Nov. 1958, by C. O. Bortels