


T.10S. R.2 W.W.M.

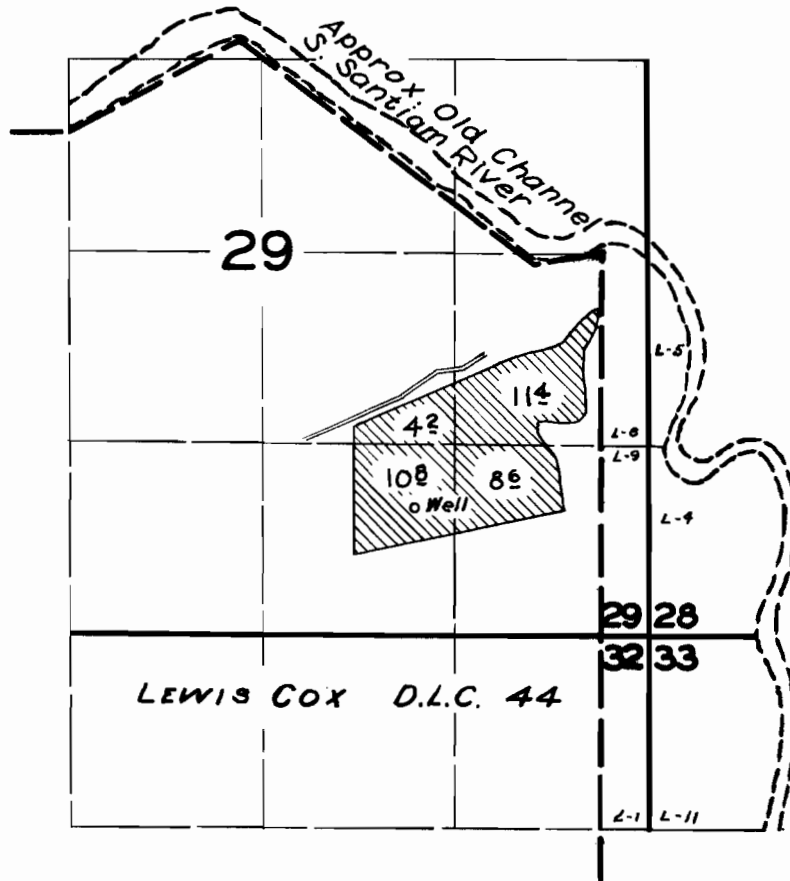

FINAL PROOF SURVEY
UNDER

Application No. G-608 Permit No. G-532
IN NAME OF

PAUL R. & JUNE E. SMITH

Surveyed 15 July 1958, by C.O. Bartels.