


T.6N. R.35E.W.M.

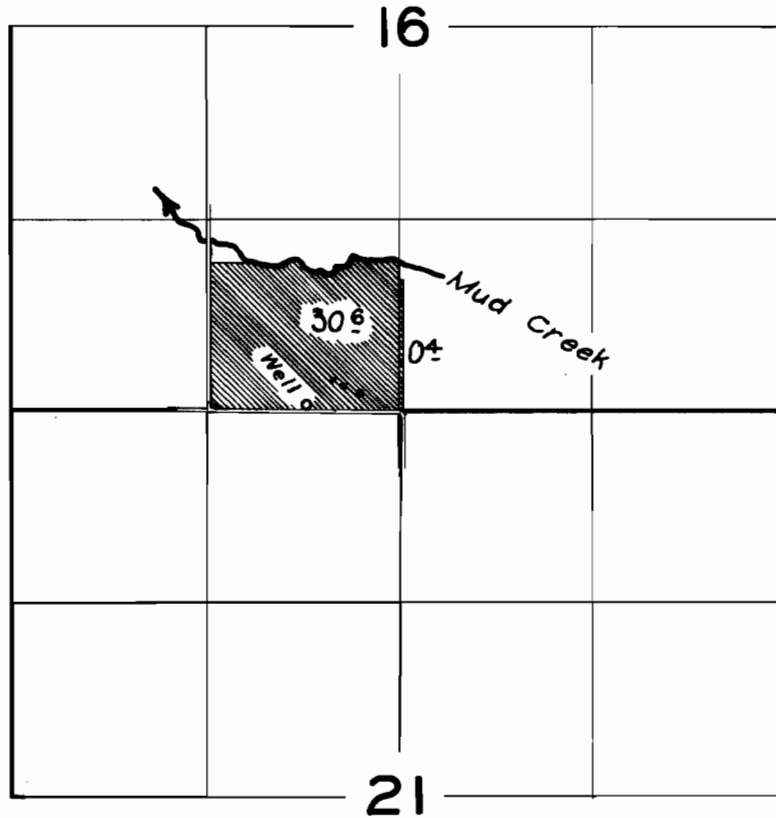

FINAL PROOF SURVEY
UNDER

Application No. G-847. Permit No. G-762.
IN NAME OF

WILLIE RAND

Surveyed 13 Nov. 1958, by C.O. Bartels...