


T.6 N. R.35 E.W.M.

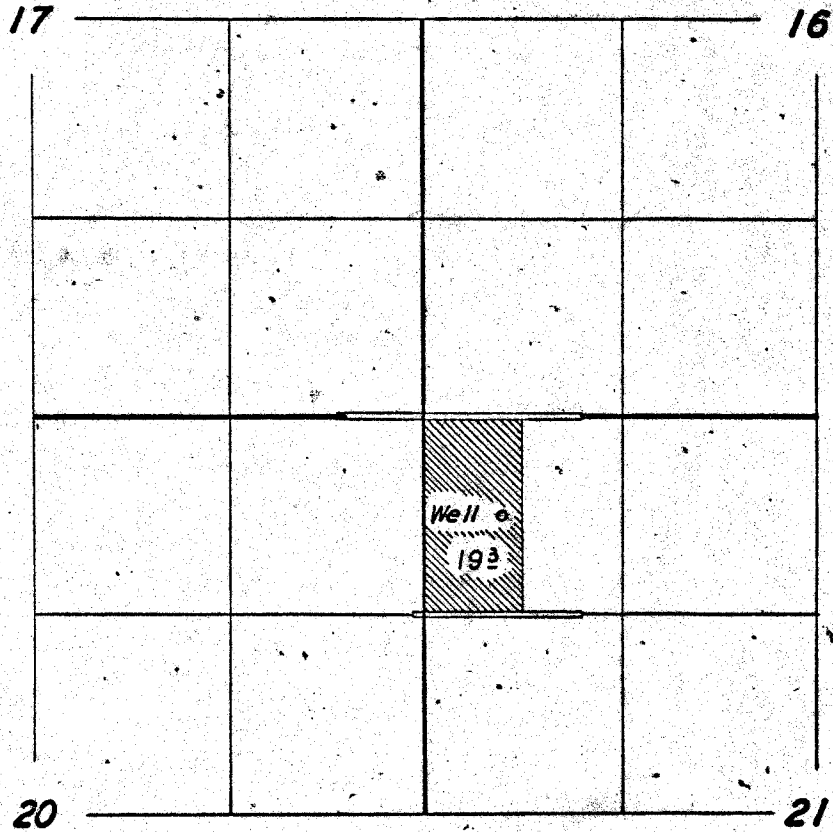

FINAL PROOF SURVEY
UNDER

Application No. G-855. Permit No. G-788.
IN NAME OF

DALE KRALMAN

Surveyed 13 Nov. 1955, by C.O. Bartels.