


G-862
26538

T.6N. R.35E.W.M.

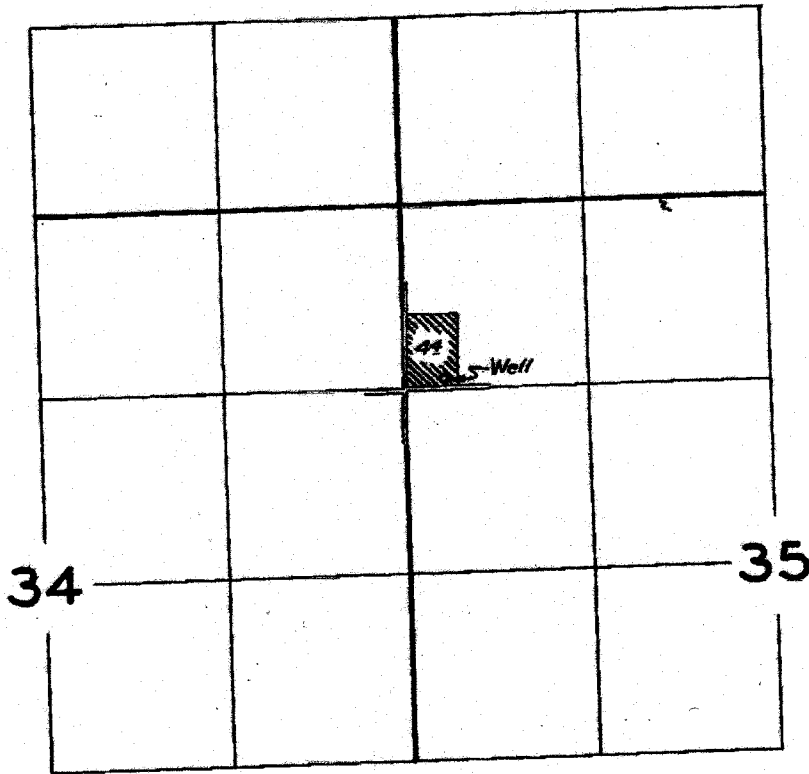

FINAL PROOF SURVEY
UNDER

Application No. G-962 Permit No. G-862
IN NAME OF

WILLIAM BRUNNER

Surveyed 13 Nov. 1958, by C.O. Bartels...

NZ-5F-62