


T. 21 S. R. 34 & 35 E. W.M.

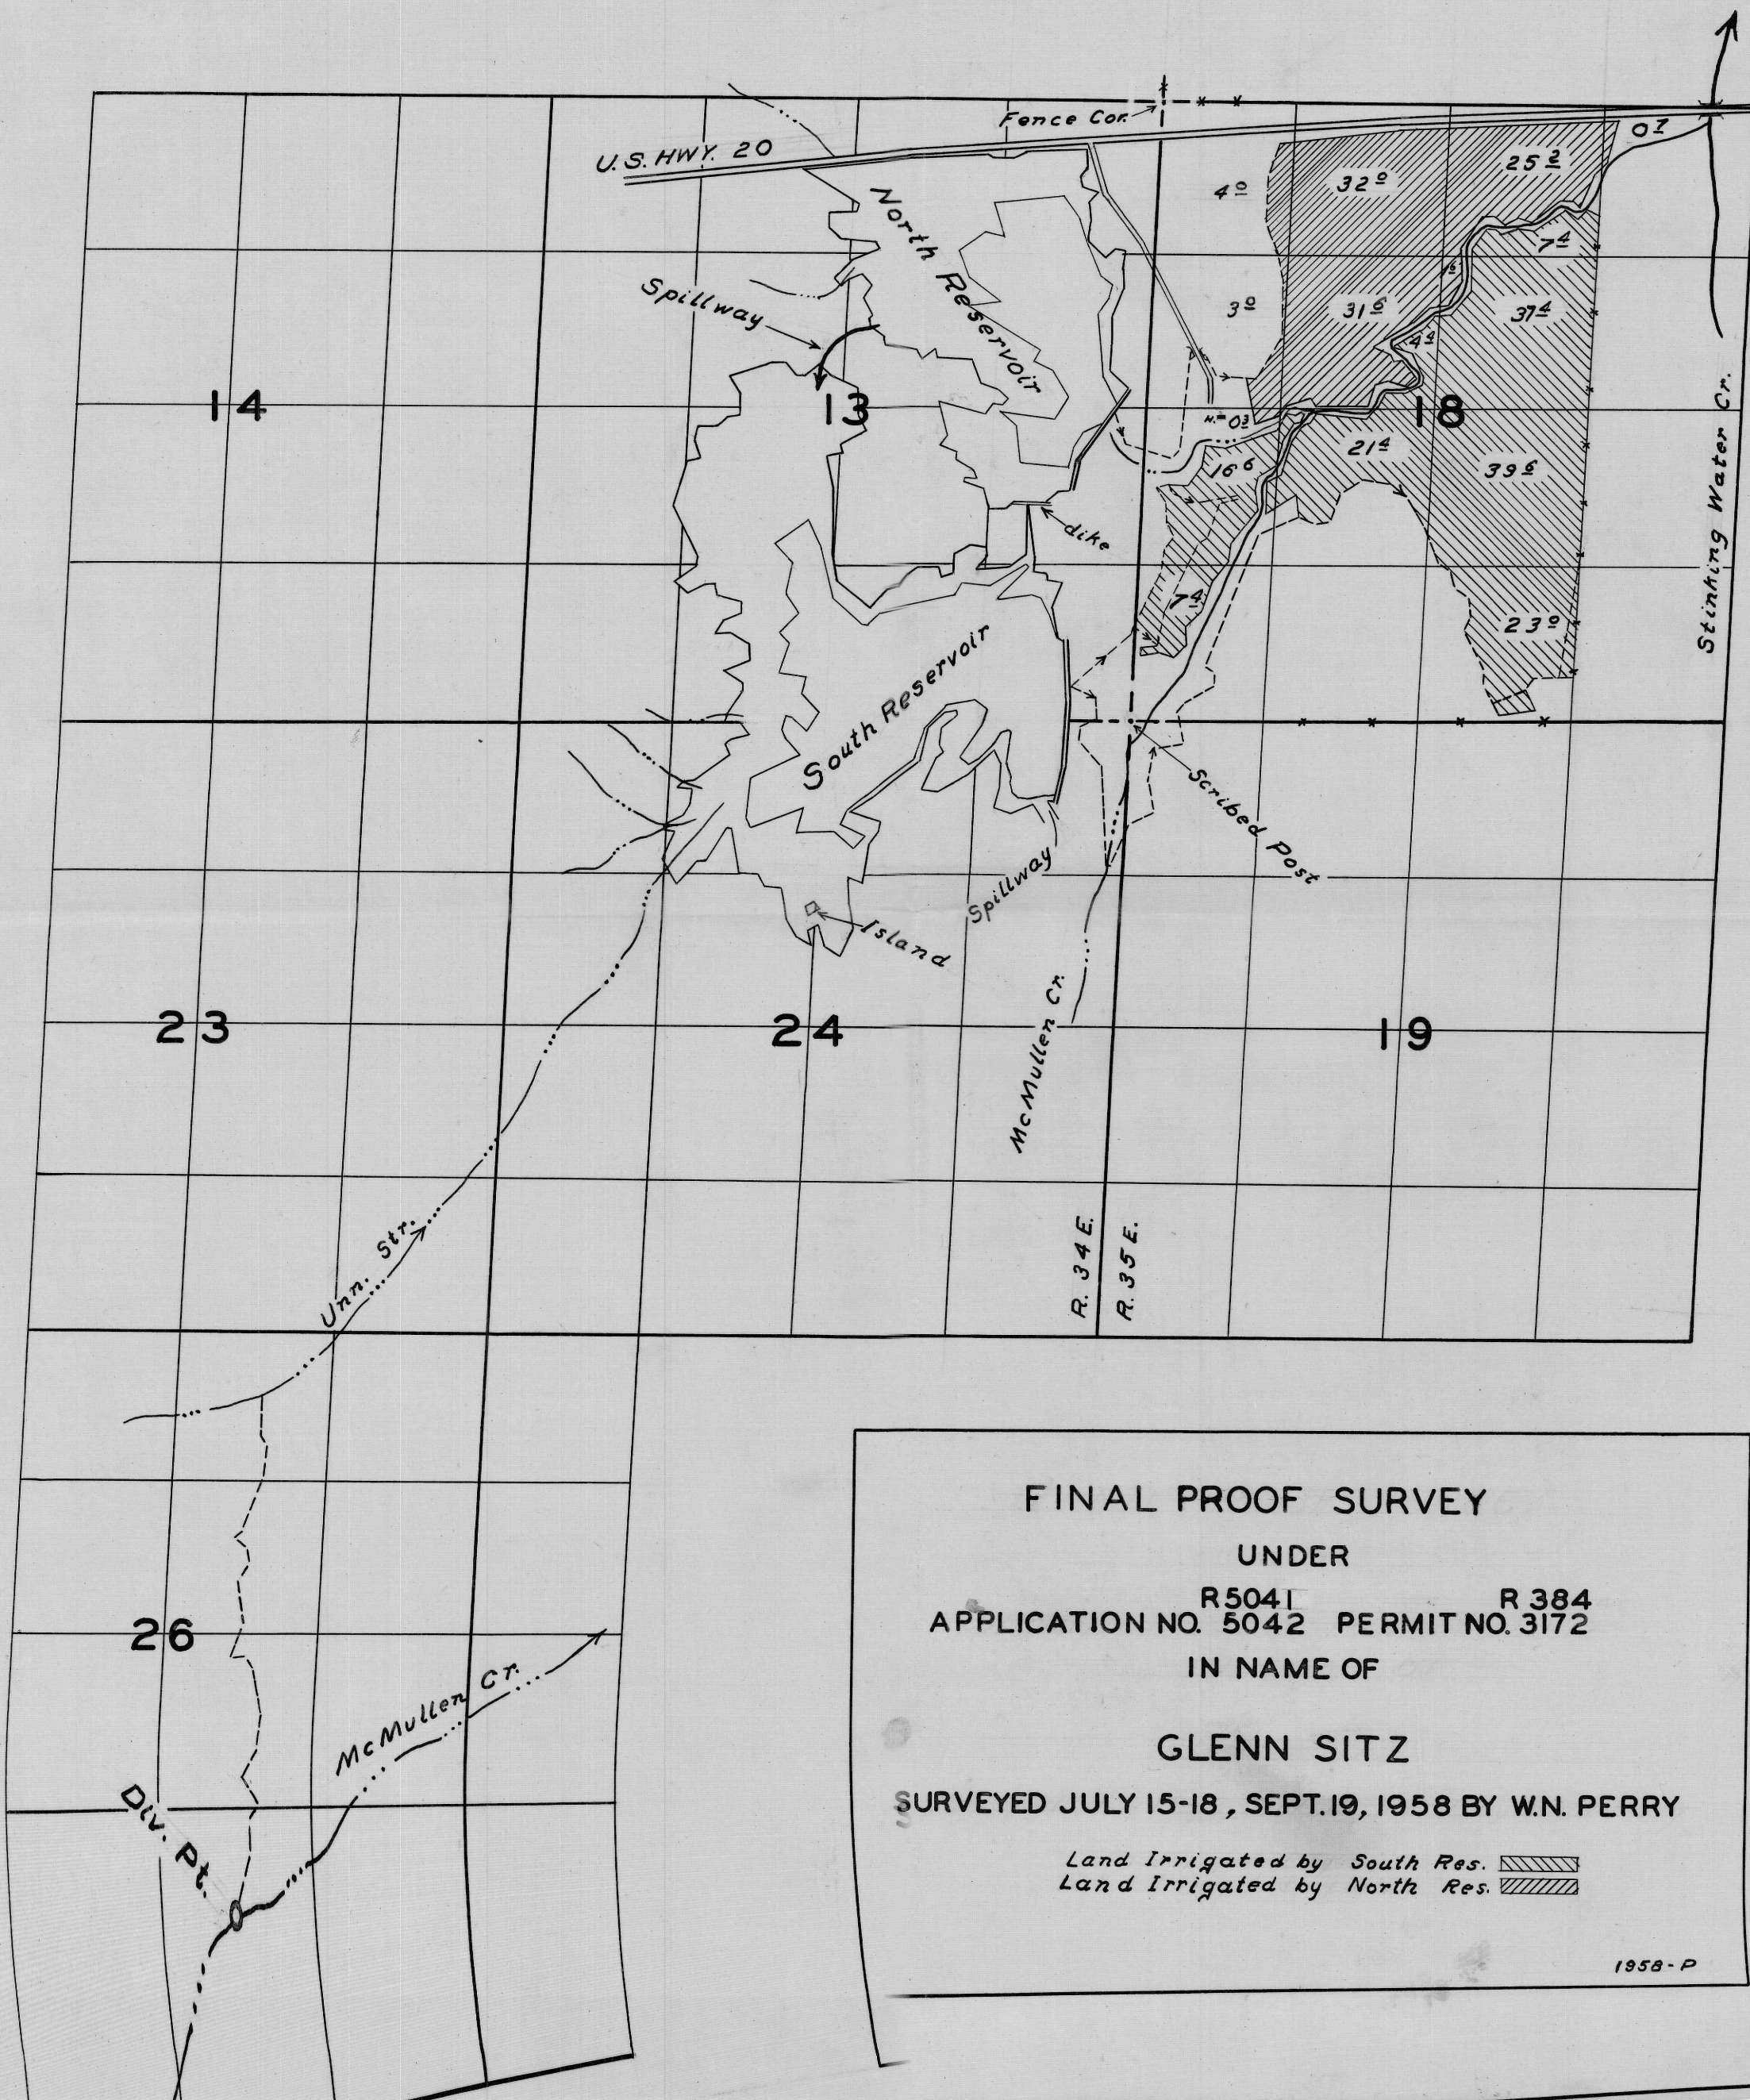

FINAL PROOF SURVEY

UNDER

APPLICATION NO. 5042 R 5041 PERMIT NO. 3172 R 384

IN NAME OF

GLENN SITZ

SURVEYED JULY 15-18, SEPT. 19, 1958 BY W.N. PERRY

Land Irrigated by South Res. 

Land Irrigated by North Res. 

1958-P