


T. 7 S. R. 38-39 E. W.M.

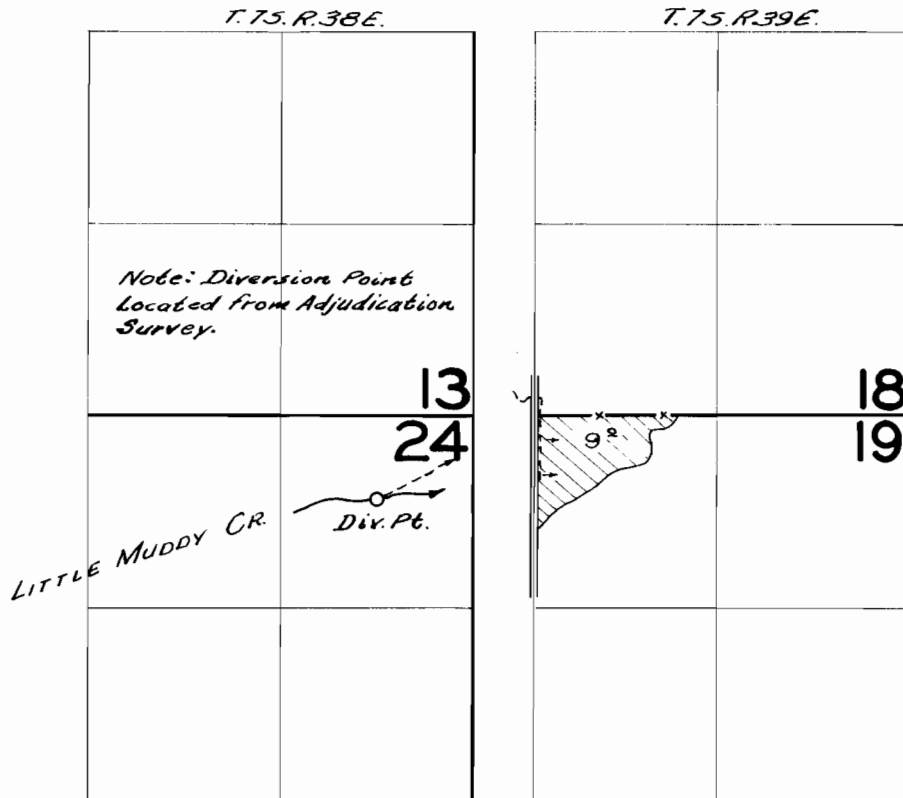

FINAL PROOF SURVEY UNDER

Application No. 13873 Permit No. 9978
IN NAME OF

Gerald Maxwell

Surveyed Aug. 23 1958, by *C.O. Bartels*