


T. 2N.R. 10W.W.M.

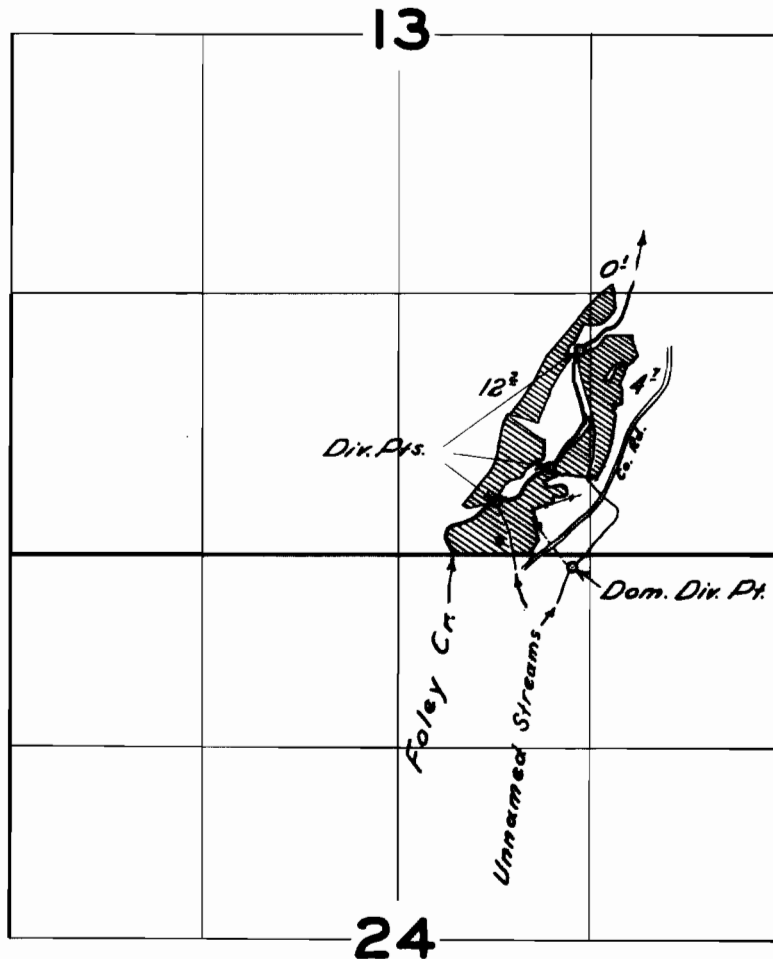

FINAL PROOF SURVEY

UNDER

23292

18375

Application No. 20320 Permit No. 15852

IN NAME OF

RALEIGH E. JACKSON

Surveyed 4 Aug. 1955, by W. H. Kelly