


T. 32 S. R. 4 W. W. M.

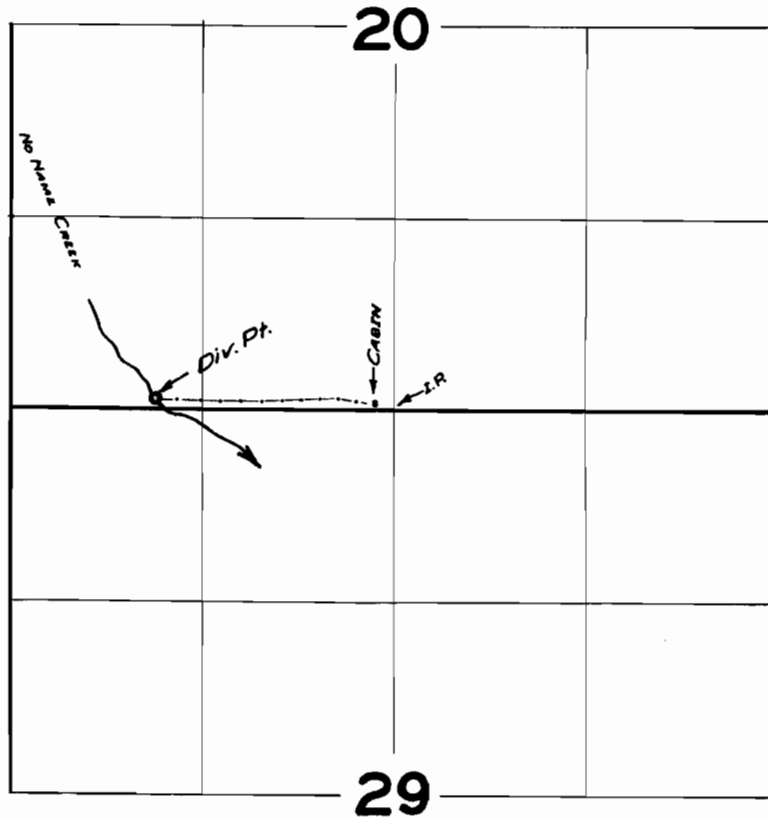

FINAL PROOF SURVEY
UNDER

Application No. 22067 Permit No. 17329
IN NAME OF

J.H. & Sylvia Jantzer

Surveyed 8 Sept. 1958, by M. Bish