


T.I.S. R.I.W.W.M.

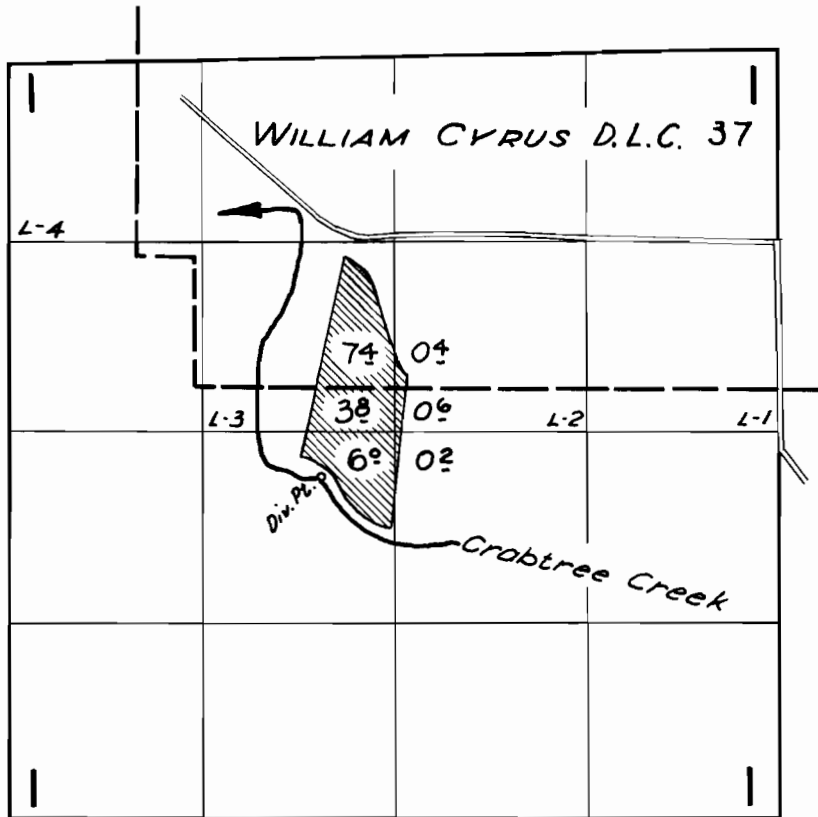

FINAL PROOF SURVEY
UNDER

Application No. 22302. Permit No. 17586.
IN NAME OF

SAM BASS

Surveyed 11 July 1958, by C.O. Bartels...