


T.13S. R.1E.W.M.

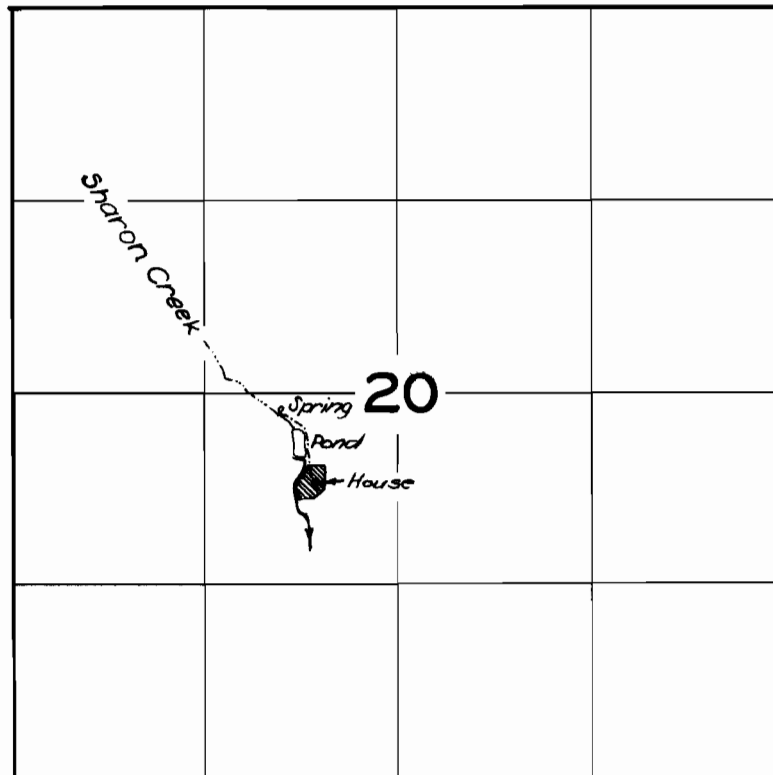

FINAL PROOF SURVEY
UNDER

Application No. 23091... Permit No. 18417...
IN NAME OF

LOWELL M. BOWSER

Surveyed 5 Sept. 1958, by C.O. Bartels