




T 8S R 6W W M

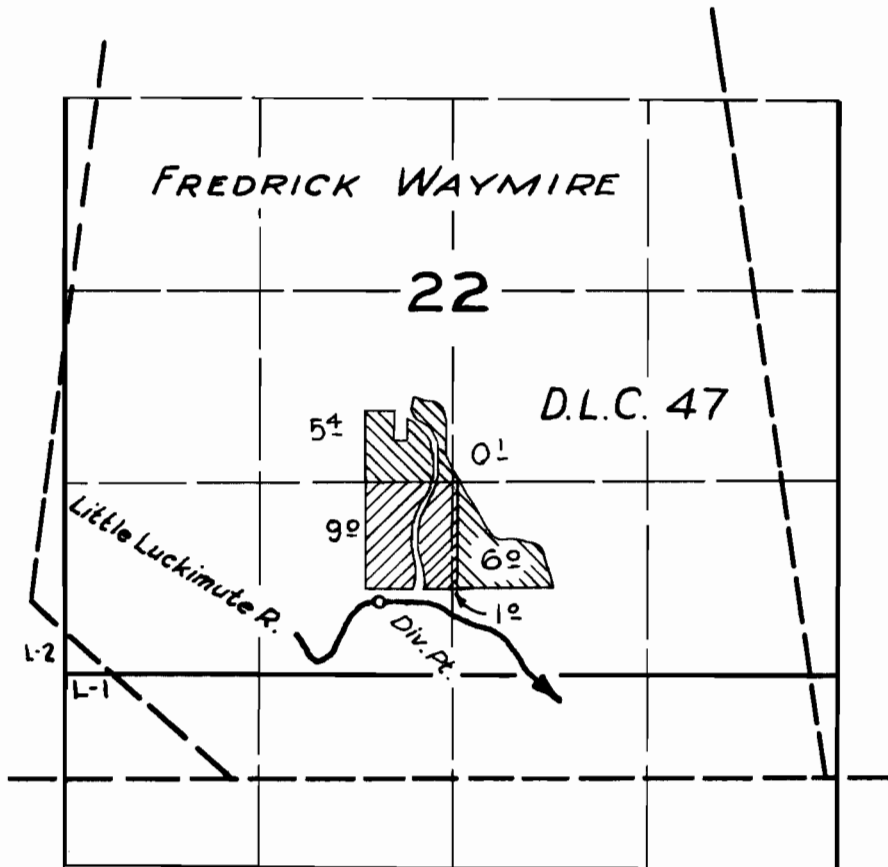

23433 
25183 

FINAL PROOF SURVEY
UNDER

Application No. 23433 18496
25183 Permit No. 19801
IN NAME OF

L. C. QUICK

Surveyed April 24 1958, by R. H. Whitby